


T.11S., R.4W., W.M.

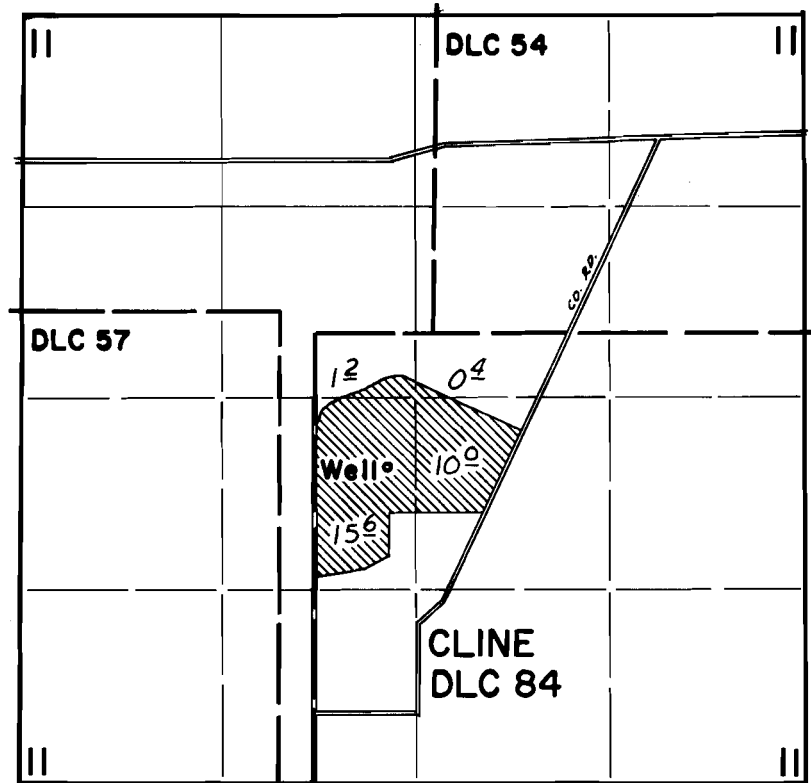


FINAL PROOF SURVEY UNDER

Application No. G-5165 Permit No. G-4897
IN NAME OF

MORRIS H. AND DOROTHY M. BERGMAN

Surveyed Oct. 1, 1973, by D. Norby