


T.10S., R.2W., W.M.

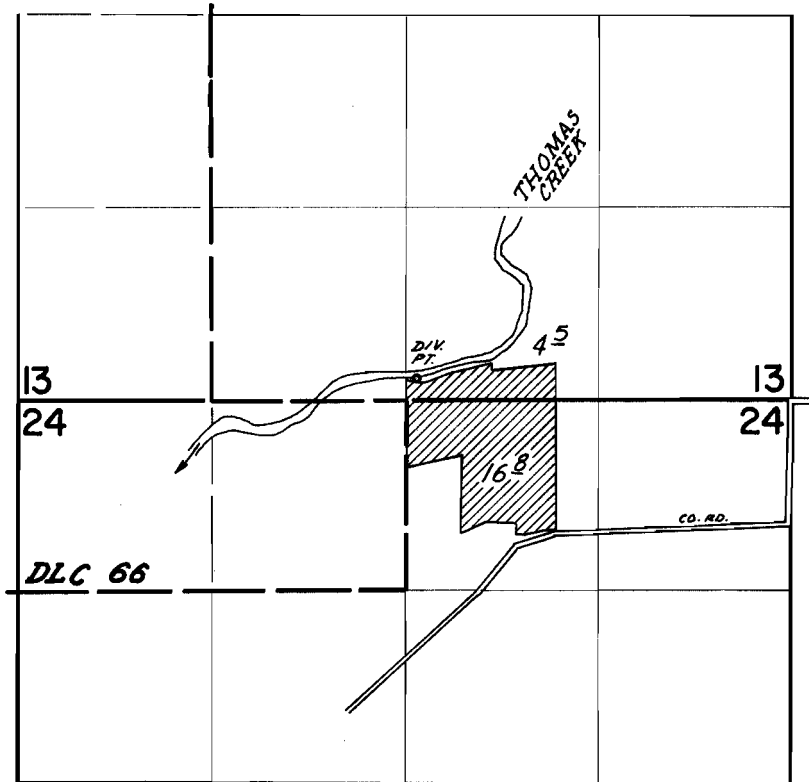

DIV. PT. LOCATED: 150' N & 2560' W FROM SE COR. SEC. 13

FINAL PROOF SURVEY UNDER

Application No. 43659 Permit No. 32638
IN NAME OF

IVY YOUNG

Surveyed June 21 1973, by D. NORBY