


T. 15 S.R. 4W. W.M

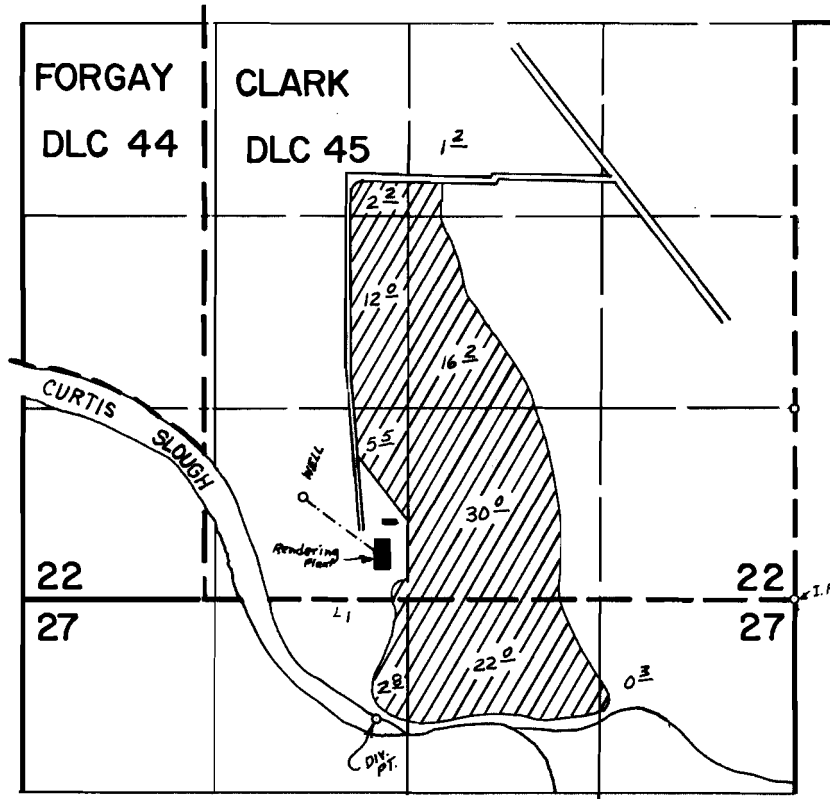

WELL 730' N & 3350' W , DIV. PT. 810' S & 2850' W FROM SE COR. SEC 22

FINAL PROOF SURVEY UNDER

G-4163

G-3914

Application No. 44328 Permit No. 33102

IN NAME OF

EUGENE CHEMICAL & RENDERING WORKS

Surveyed OCT. 22, 1973, by R.G. MUCKEN