




T. 9 S., R. 1 E., W. M.

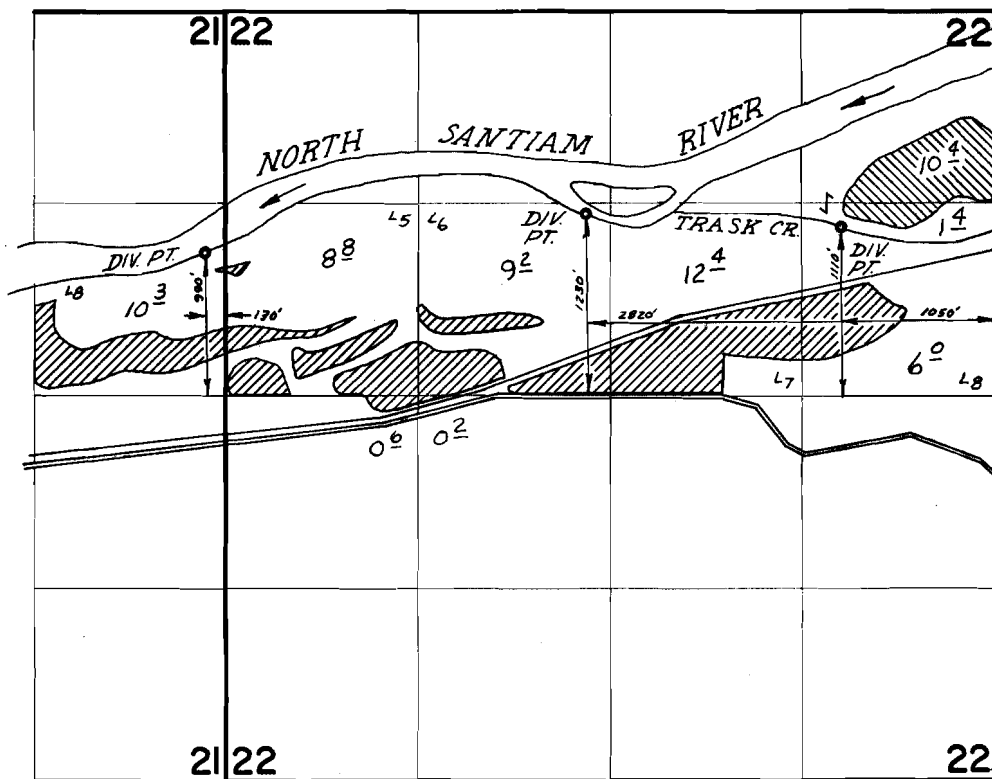

 NORTH SANTIAM RIVER
 TRASK CREEK

FINAL PROOF SURVEY
UNDER

Application No. 44460 Permit No. 33254
IN NAME OF

KORA PRITCHARD

Surveyed July 5 1973, by D. Noeby