


T.13S.R.1W.W.M.

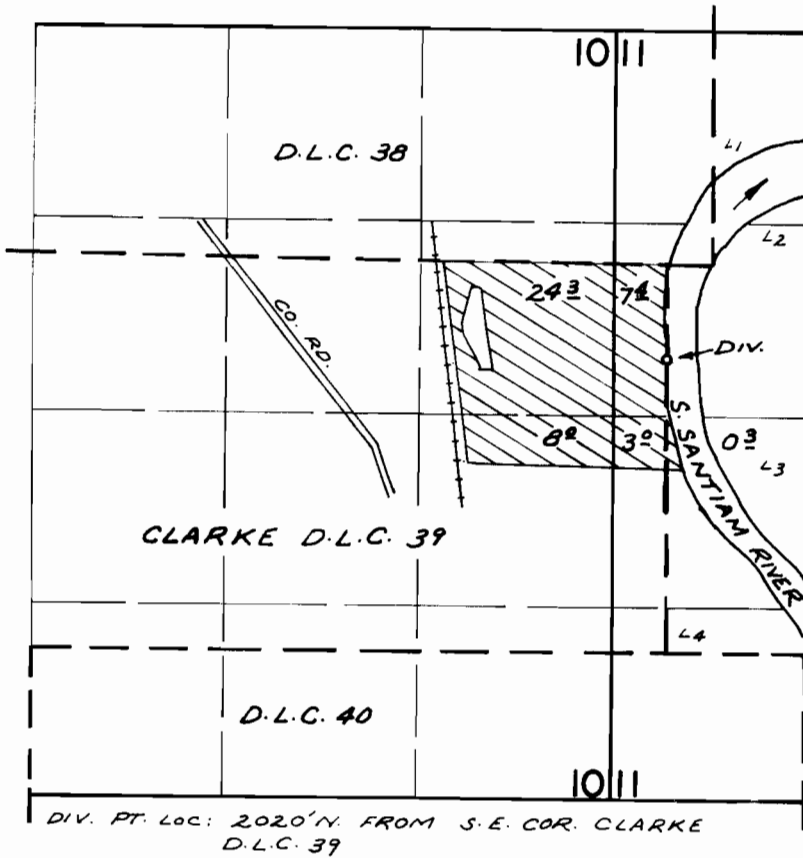

FINAL PROOF SURVEY UNDER

Application No. 46161 Permit No. 34486
IN NAME OF

ALBERT C. & DOROTHY M. LANE

Surveyed APR. 9, 1973, by R. G. MUCKEN