


T.14S.R.1W.W.M.

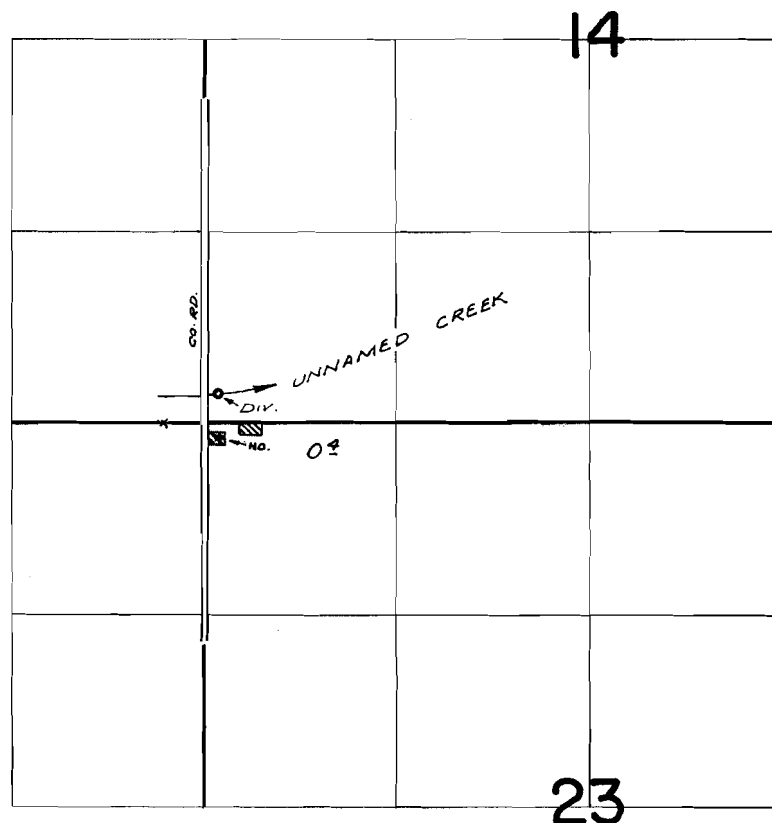

DIV. PT. LOC: 190' N. & 80' E. FROM S.W. COR. SEC. 14

FINAL PROOF SURVEY
UNDER

Application No. 48514 Permit No. 35505
IN NAME OF

WALTER W. EVERGIE I. RICE

Surveyed OCT. 30, 1973, by R. MUCKEN