


T.I.O.S.R.I.W.W.M.

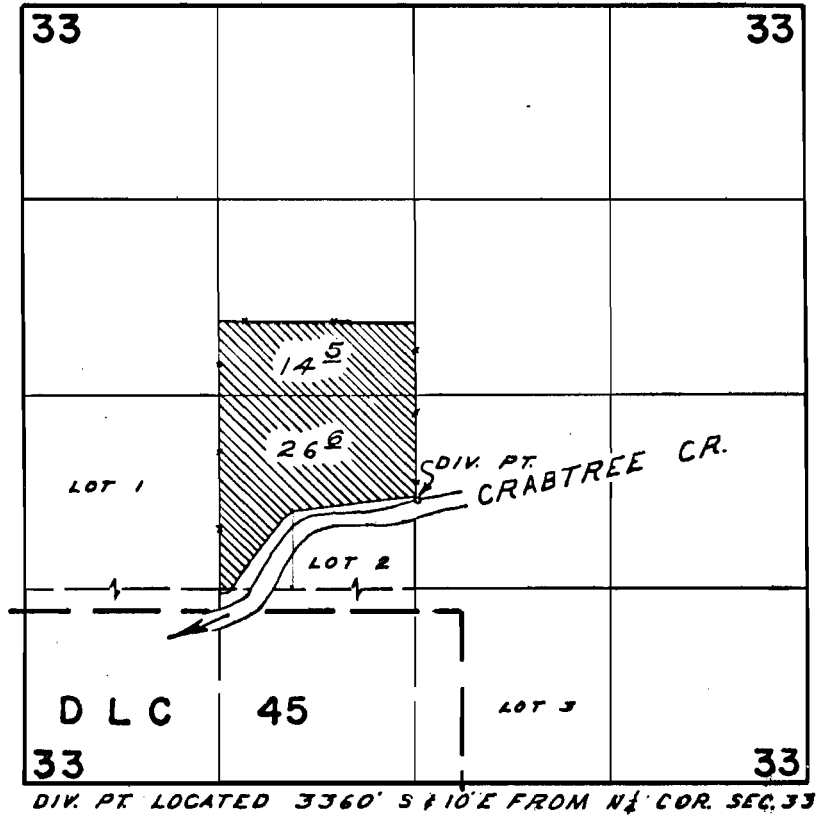

FINAL PROOF SURVEY
UNDER

Application No. 39389... Permit No. 29357...
IN NAME OF

HARVEY A. and CECELIA R. FERY.

Surveyed MARCH 28, 1969., by W. J. RUPPERT

*Application Number 48013
Permit Number 36009*

1969-J
DT