


T.13S.R.1E.W.M.

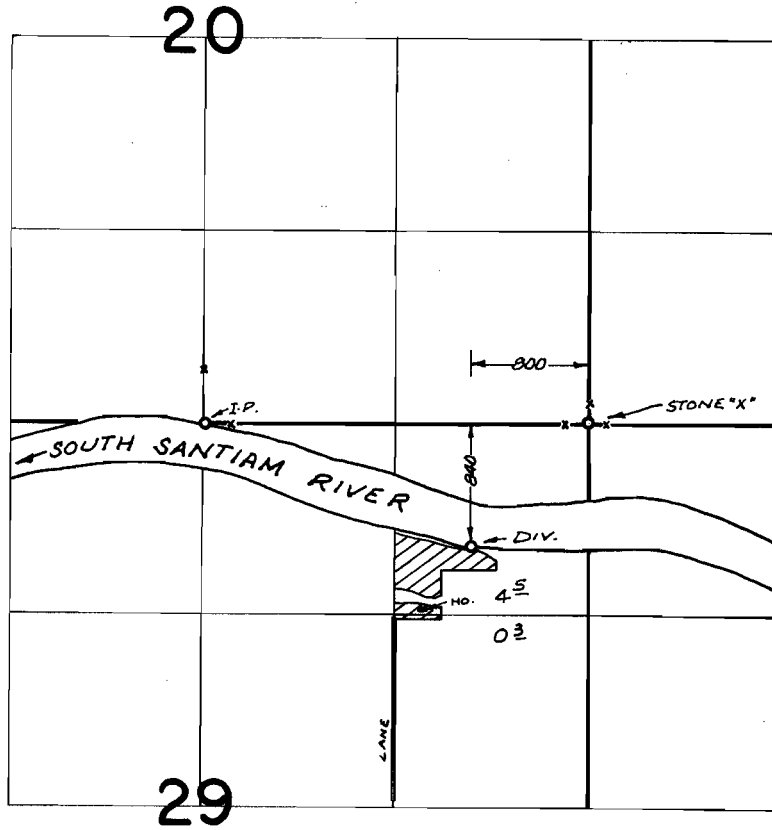

FINAL PROOF SURVEY
UNDER

Application No. 48165 Permit No. 36183
IN NAME OF

GEORGE E. KIVIAN I. FINER

Surveyed MAY 8, 1973, by R. MUCKEN