


T.10S., R.3W., W.M.

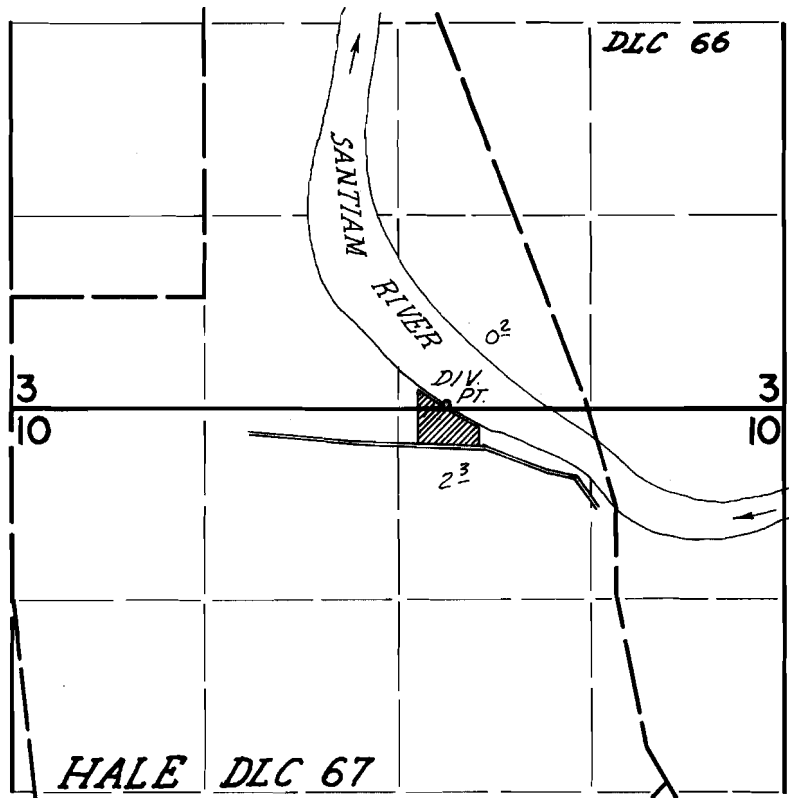

DIV. PT. LOCATED: 20' N & 2970' E FROM SW COR. SEC. 3.

FINAL PROOF SURVEY
UNDER

Application No. 48525 Permit No. 36408
IN NAME OF

ROBERT G. BRUCE

Surveyed June 22 1973, by D. Noeby