


T.14S.R.1W.W.M.

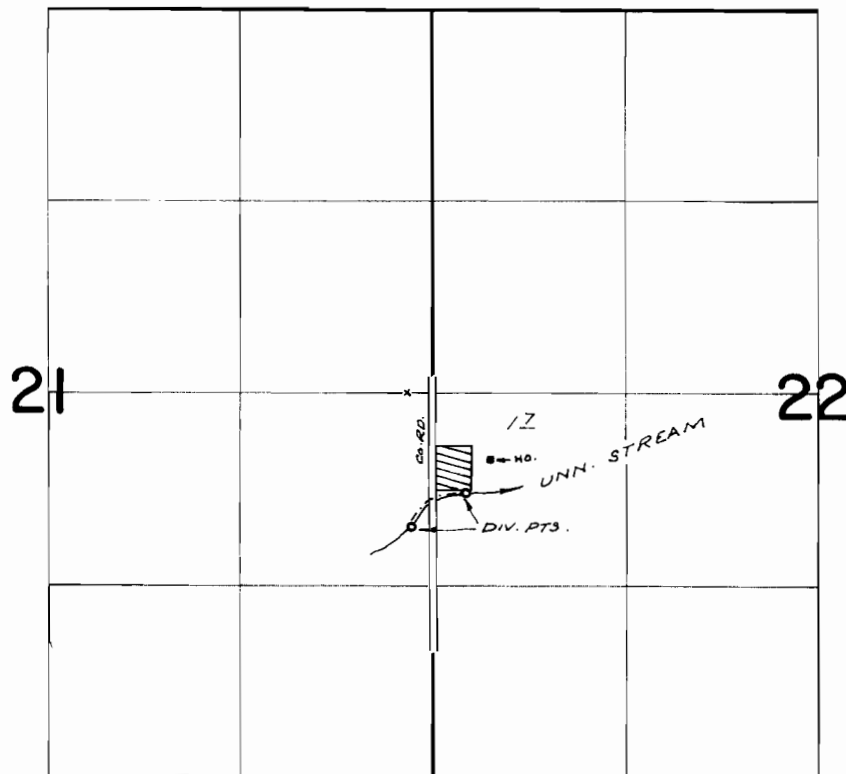

DIV. PTS. LOC: 130' W. & 920' S ; 220' E. & 680' S, BOTH
FROM W & COR. SEC. 22

FINAL PROOF SURVEY
UNDER

Application No. 48757 Permit No. 36568
IN NAME OF

ALBERT & NITA ABENROTH

Surveyed OCT. 30, 1973, by R. MUCKEN