


T.I.S., R.I.E., W.M.

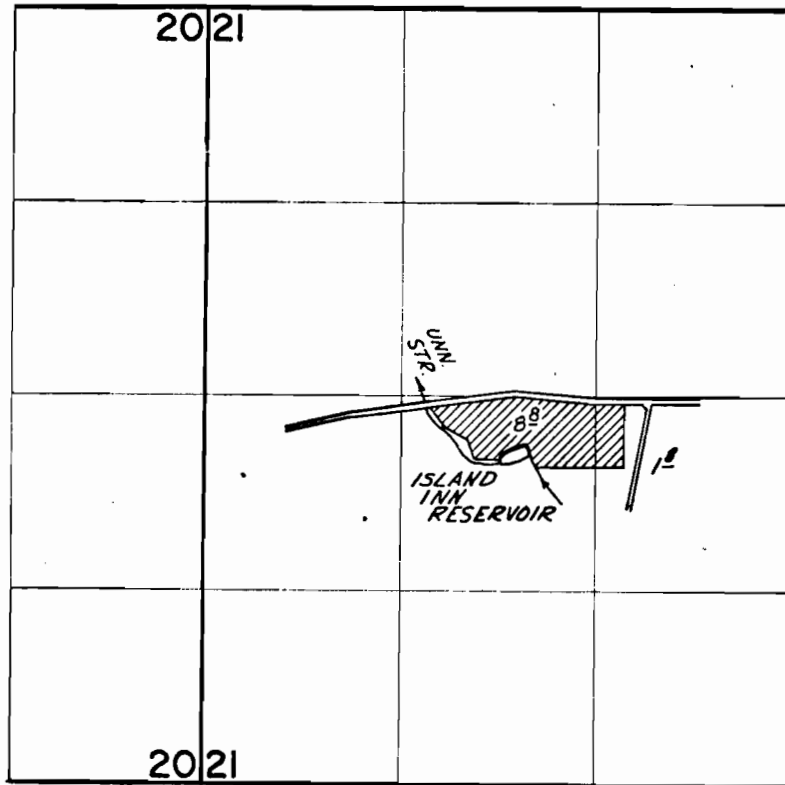

RES. LOCATED: 870' N AND 1770' W FROM SE COR NW $\frac{1}{4}$ SE $\frac{1}{4}$ SEC 21.

FINAL PROOF SURVEY
UNDER

R-44629 R-5280
Application No. 44630 Permit No. 33391
IN NAME OF

D. W. AND VERNA RUTHERFORD

Surveyed JULY 2, 1973, by D. NORBY