
T. 4 S.R. I W. W.M.

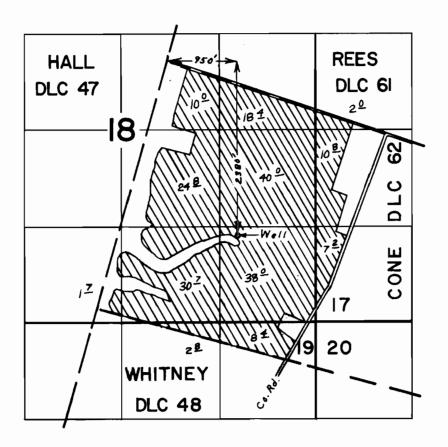

FINAL PROOF SURVEY

Application No. G-3679 Permit No. G-3485
IN NAME OF

ERSEL E. CHRISTOPHERSON

Surveyed AUG 16 19 73, by L.E. GOULD