T. 4 S. R. 1 W. W.M.

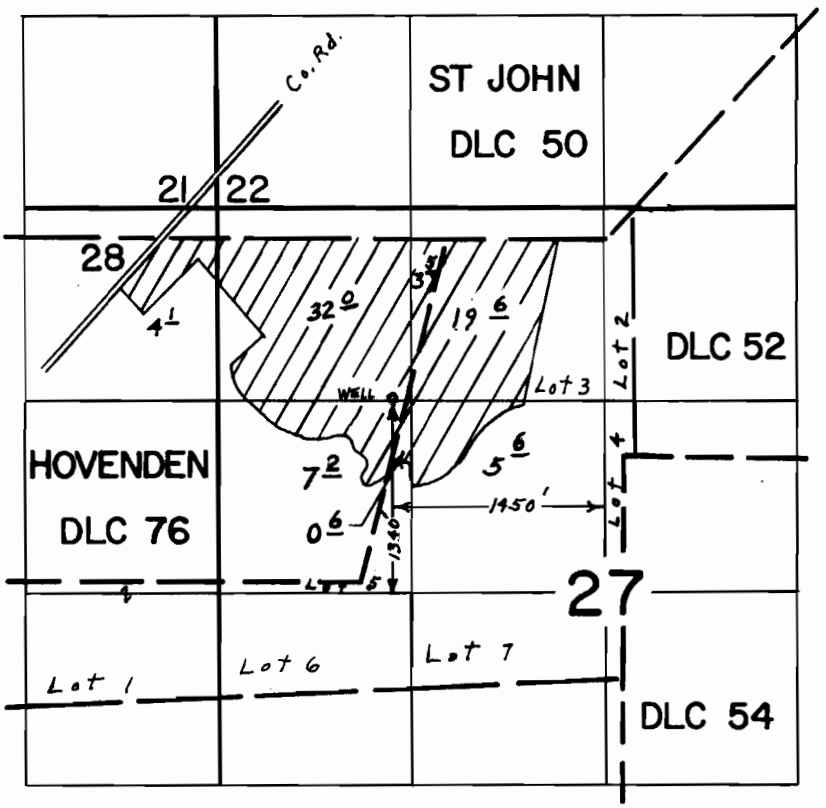

FINAL PROOF SURVEY
UNDER

Application No. G-3769 Permit No. G-3555
IN NAME OF

SHADY OAK RANCH, INC.

Surveyed AUG 15 19 73, by L.E. GOULD

DFN-1LL-65 D.C.