


T.4S.R.1W.W.M.

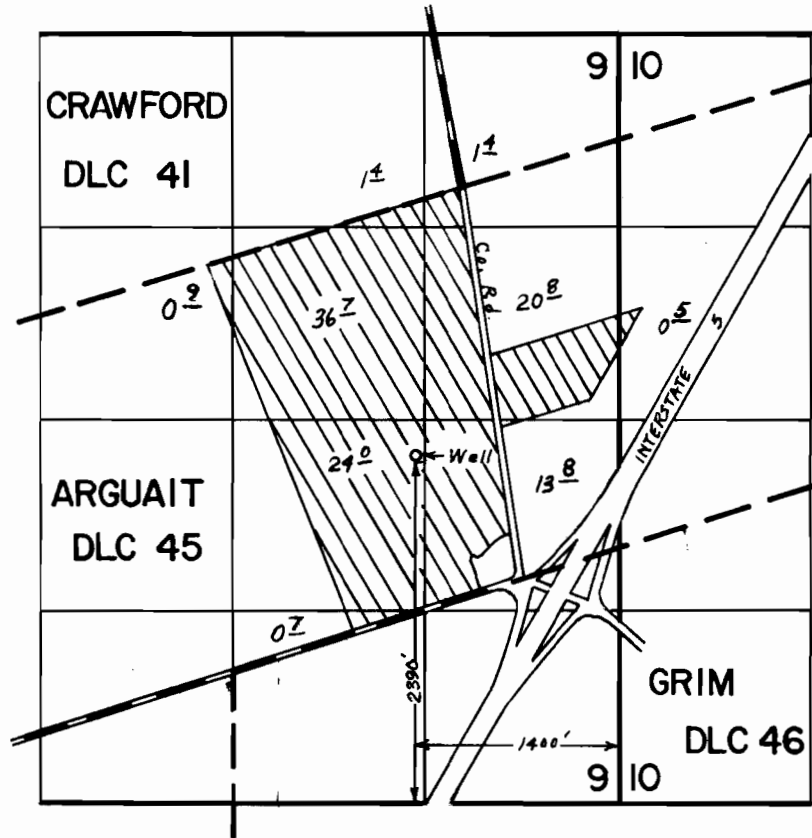

FINAL PROOF SURVEY UNDER

Application No. G-3871 Permit No. G-3580
IN NAME OF

ARTHUR JAY CANBY

Surveyed AUG 14 1973, by L.E. GOULD