


T.8S.R.1W.W.M.

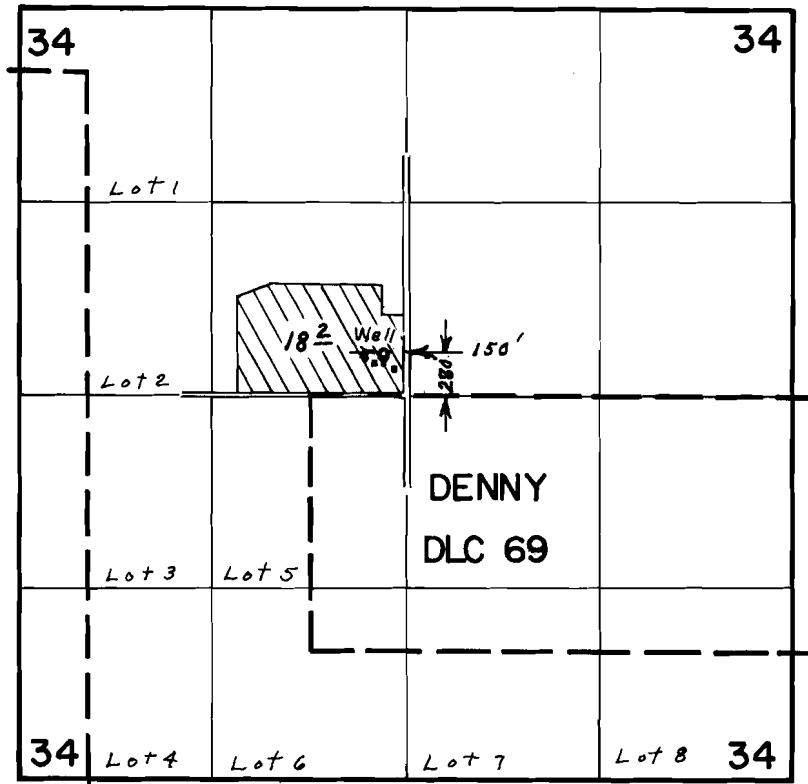

FINAL PROOF SURVEY UNDER

Application No. G-4321 Permit No. G-4079
IN NAME OF

RAYMOND S. & IDA K. HARTMANN

Surveyed MAY 18 1973, by L.E. GOULD