


# T. 4 S. R. 1 W. W.M.

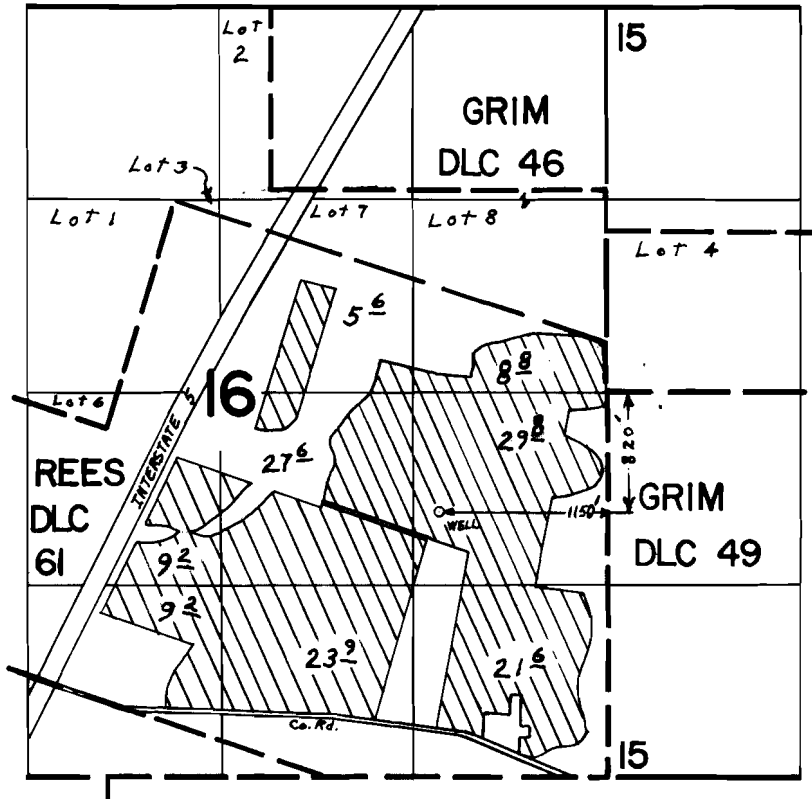

## FINAL PROOF SURVEY UNDER

Application No. G-4325 Permit No. G-4082  
IN NAME OF

THEODORE F. ZACHER

Surveyed AUG 16 1973, by L.E. GOULD