


T.3&4S.R.IW.W.M.

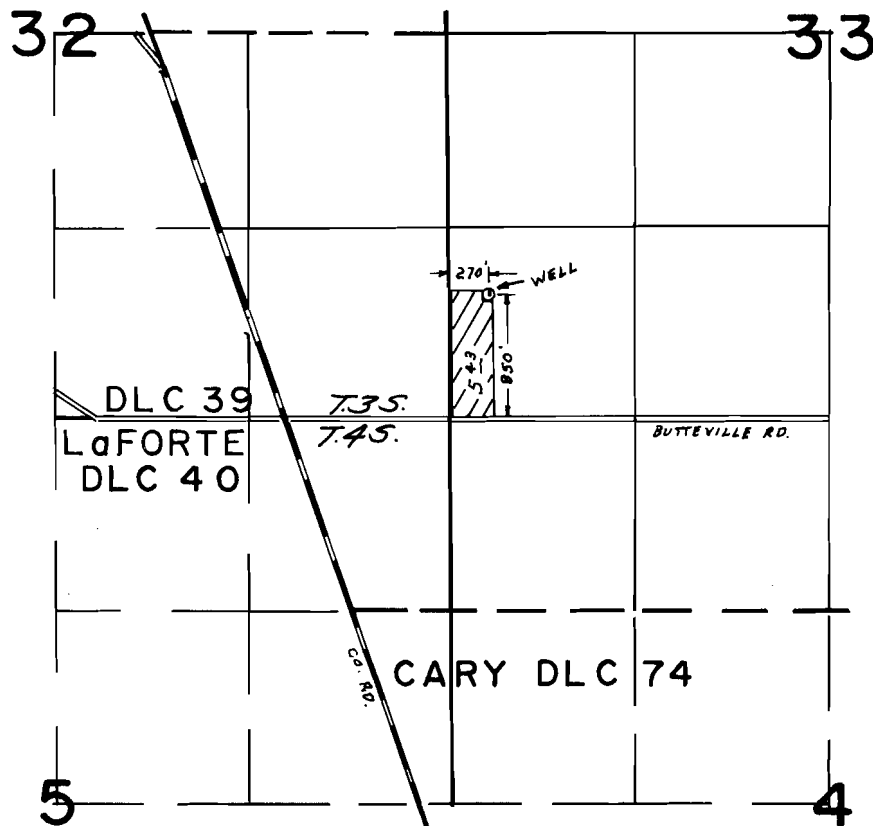

FINAL PROOF SURVEY
UNDER

Application No. G-4471 Permit No. G-4213
IN NAME OF

Robert L. & Katherine Kenyon

Surveyed MAY 23 1974, by L. H. NUNN