


T. 6 S. R. 2 W. W.M.

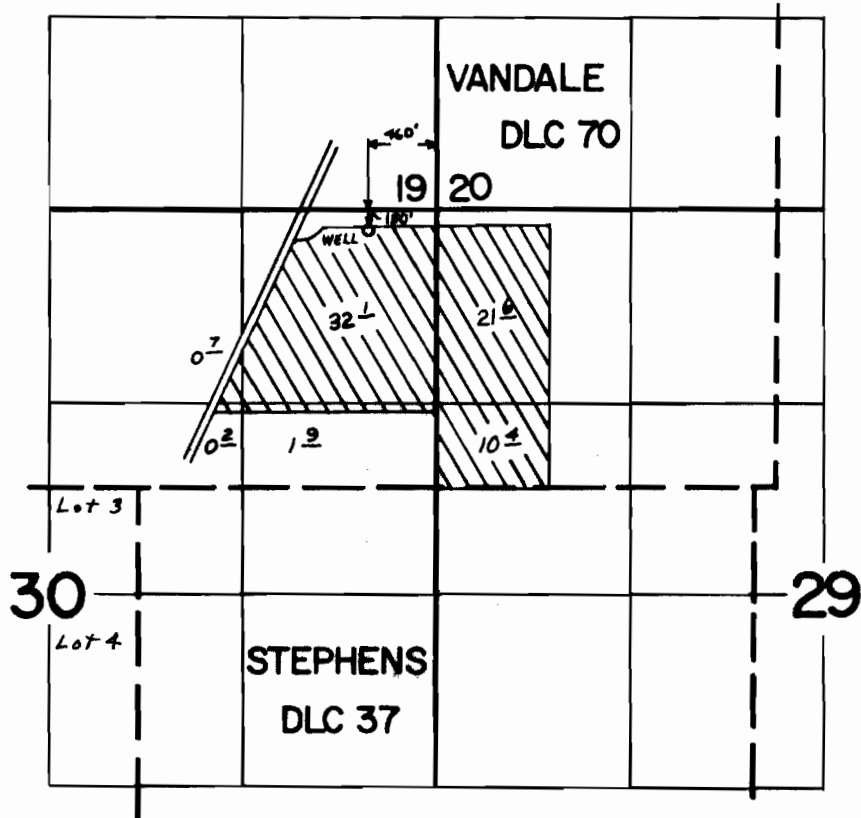

FINAL PROOF SURVEY
UNDER

Application No. G-4892 Permit No. G-4613
IN NAME OF

A. EUGENE PETROFF

Surveyed JULY 2 1973, by L. E. GOULD