


T. 8 S. R. 1 W. W.M.

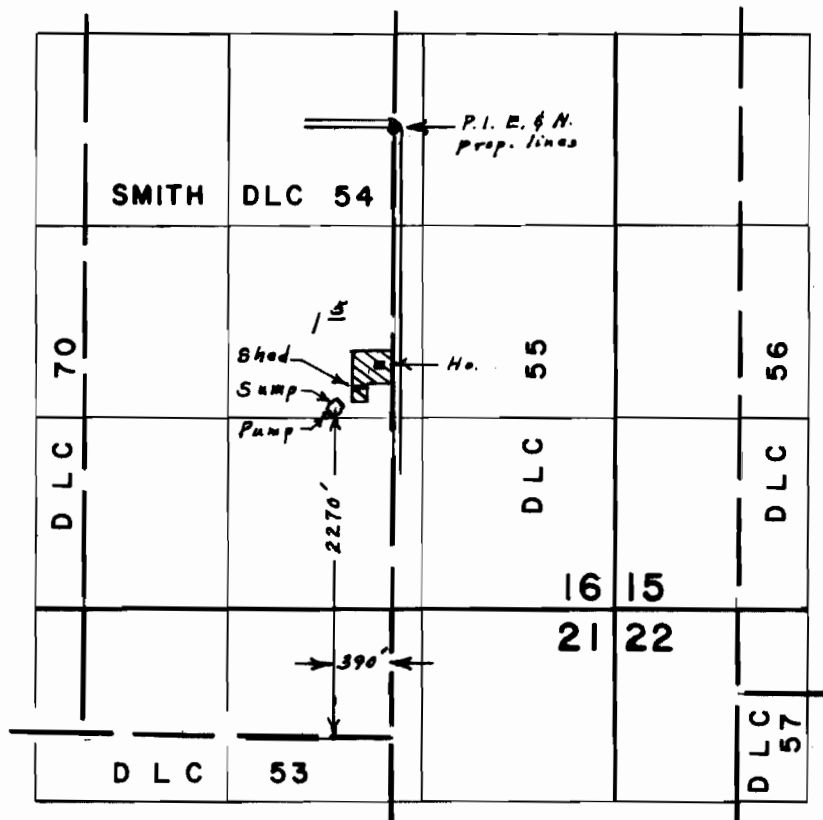

FINAL PROOF SURVEY
UNDER

Application No. G-4948 Permit No. G-4670
IN NAME OF

BERT W. HARRISON

Surveyed May 18, 1973, by L. E. Gould.