


T.5S.R.1W. W.M.

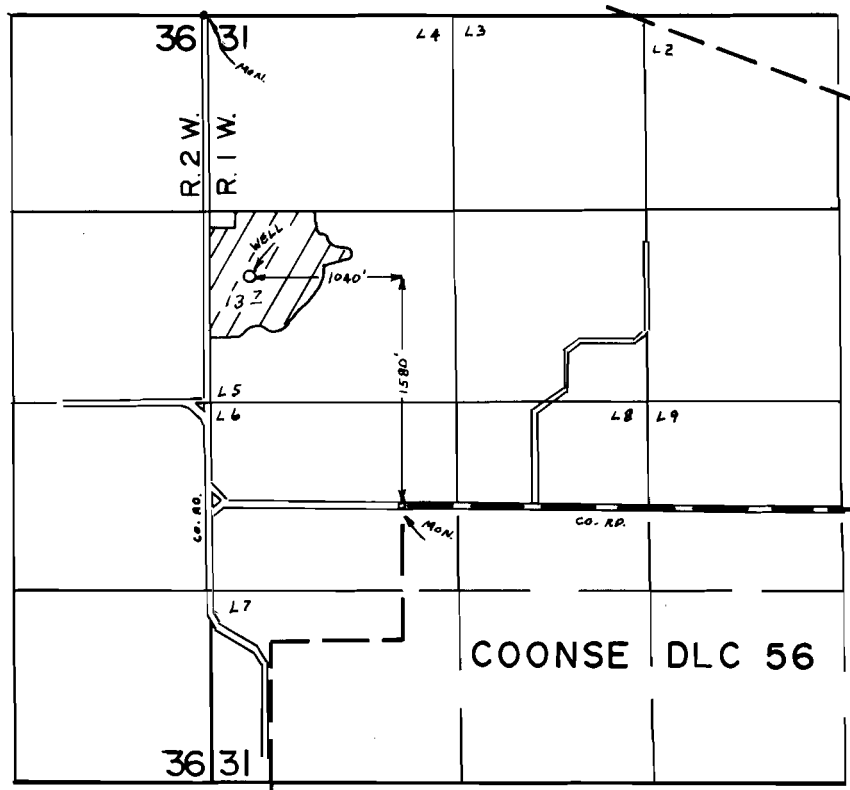

**FINAL PROOF SURVEY**  
UNDER

Application No. G-5146 Permit No. G-4879  
IN NAME OF

EGOR SANAROV

Surveyed SEP 4 1974, by L.H. NUNN