


T. 4 S. R. 1 W. W. M.

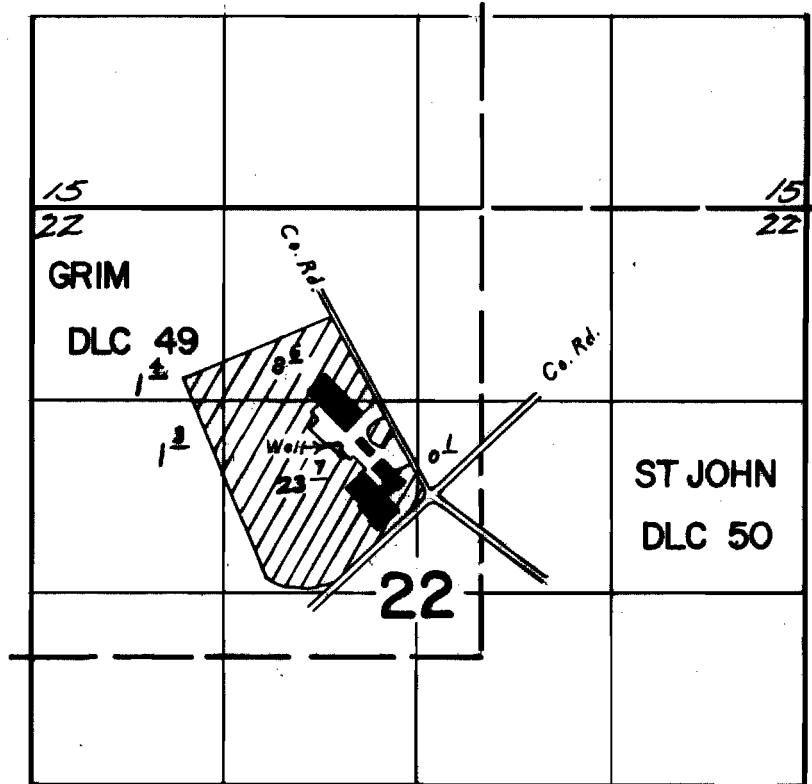

Well located 1440' N. & 5470' E. from S.W. Cor. Grim D.L.C. 49

FINAL PROOF SURVEY UNDER

Application No. G-5171 Permit No. G-4902
IN NAME OF

NORTH MARION SCHOOL DISTRICT #15

Surveyed AUG 15 1973, by L.E. GOULD