


T. 6 S. R. 1 W. W. M.

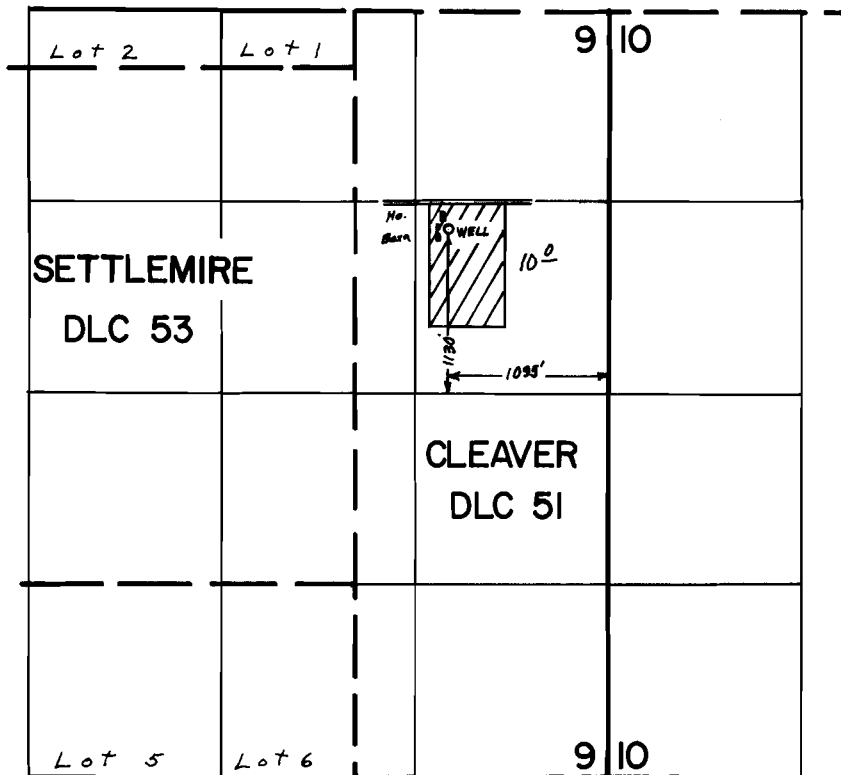

FINAL PROOF SURVEY UNDER

Application No. G-5198 Permit No. G-5066
IN NAME OF

JOHN GREALISH

Surveyed JULY 2 1973, by L.E. GOULD