


T.4 S.R. I.W. W.M.

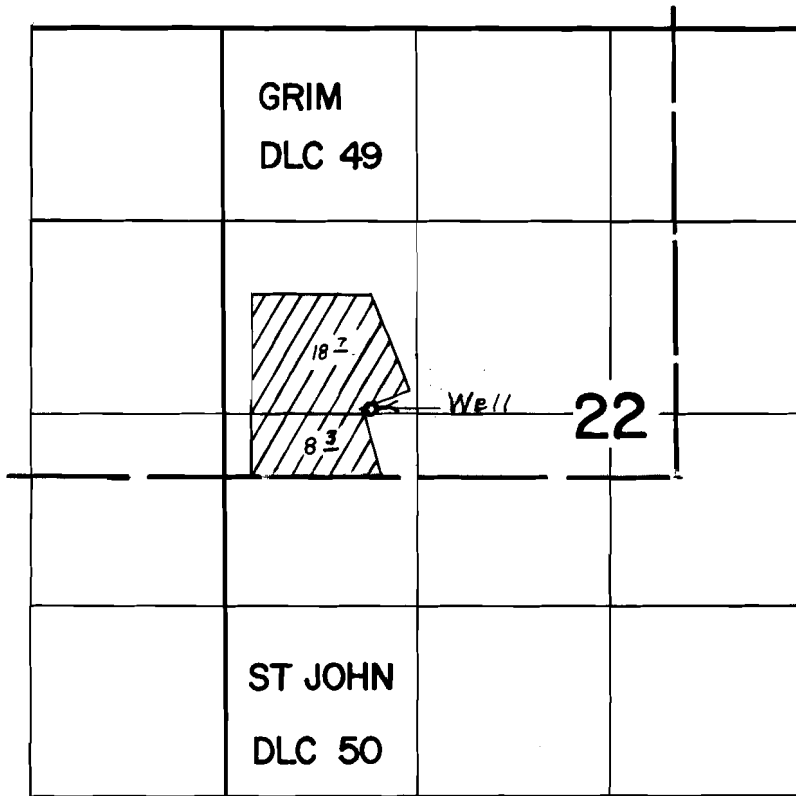

Well located 470' N. & 4370' E. from S.W. Cor. Grim D.L.C. 49

FINAL PROOF SURVEY
UNDER

Application No. G-5230 Permit No. G-5088
IN NAME OF

VAN VEEN NURSERY

Surveyed AUG 15 19 73, by L. E. GOULD