


# T.9 S.R.1W.W.M.

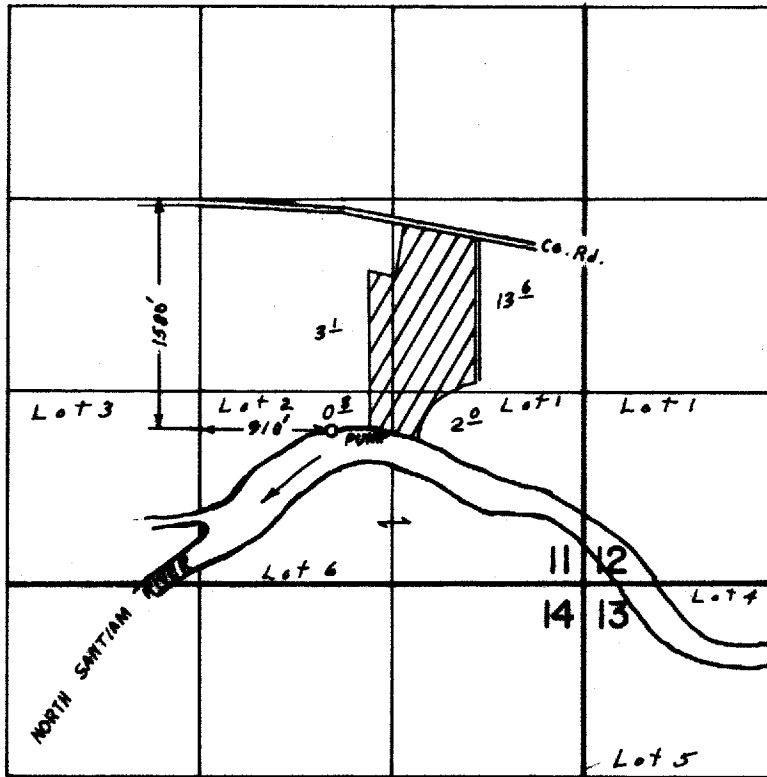

## FINAL PROOF SURVEY UNDER

Application No. 39494 Permit No. 29609  
IN NAME OF

HELEN M. BURR

Surveyed MAY 17 1973, by L.E. GOULD