


T.6S.R.1W. W.M.

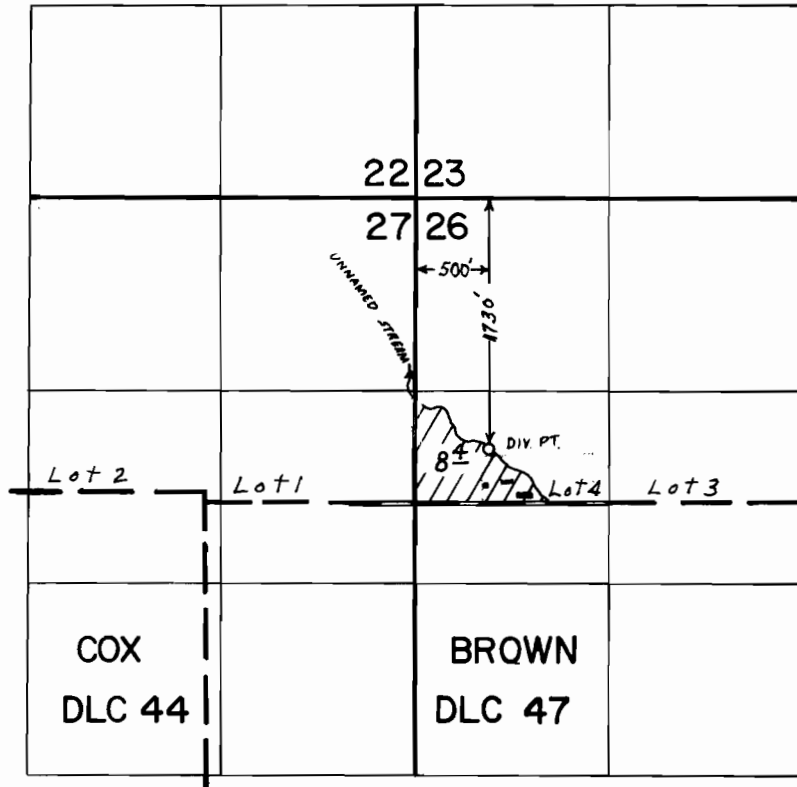

FINAL PROOF SURVEY UNDER

Application No. 44983 Permit No. 33623
IN NAME OF

ELBERT DEGUIRE

Surveyed JULY 2 1973, by L.E. GOULD