


T. 8 S. R. 4 W. W.M.

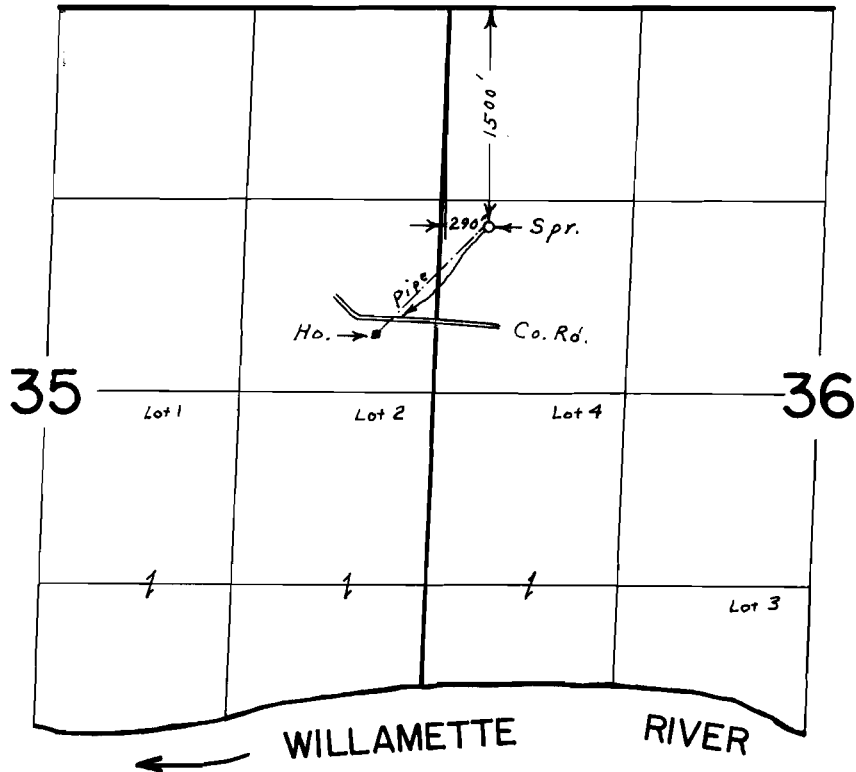

FINAL PROOF SURVEY
UNDER

Application No. 45928 Permit No. 34212
IN NAME OF

GERALD ELLIS LAUDERBACK

Surveyed MAY 15 1973, by L.E. GOULD