



# T.4S.R.2W.W.M.

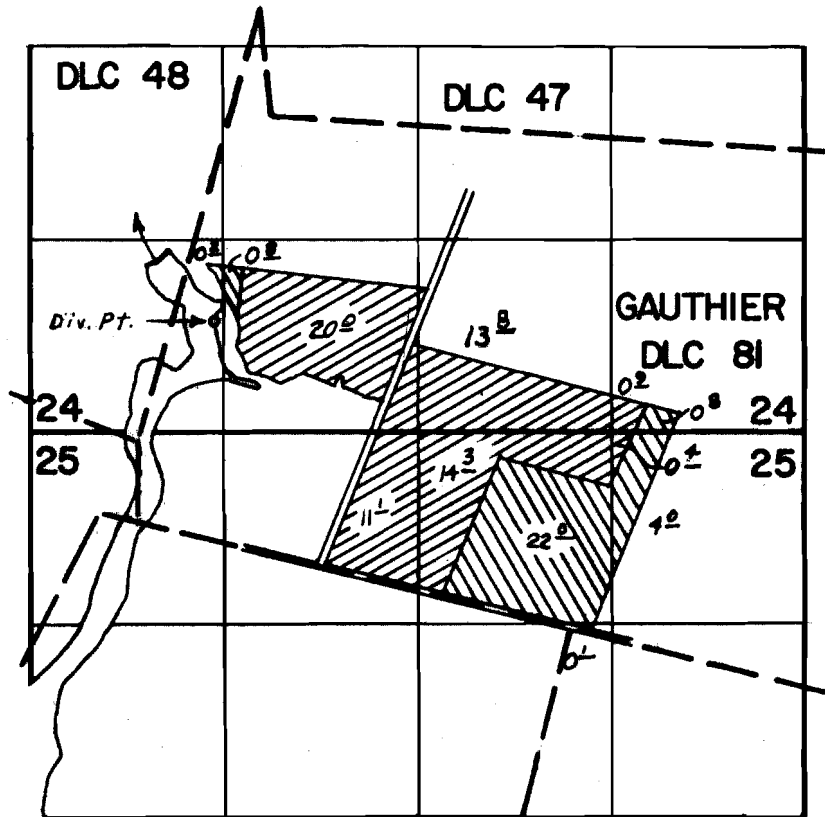

Div. Pts. located: Res., 1800' N. & 140' E.; Case Cr., 1320' N. & 520' E., both from S.W. Corner Gauthier D.L.C. 81

PRIMARY  
SUPPLEMENTAL

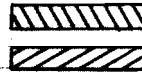

## FINAL PROOF SURVEY UNDER

Application No. 44866 Permit No. 34415  
IN NAME OF

ROBERT G. WILLIAMSON

Surveyed AUG. 17, 1973, by L.E. GOULD