


T.7 S.R. 1 E. W.M.

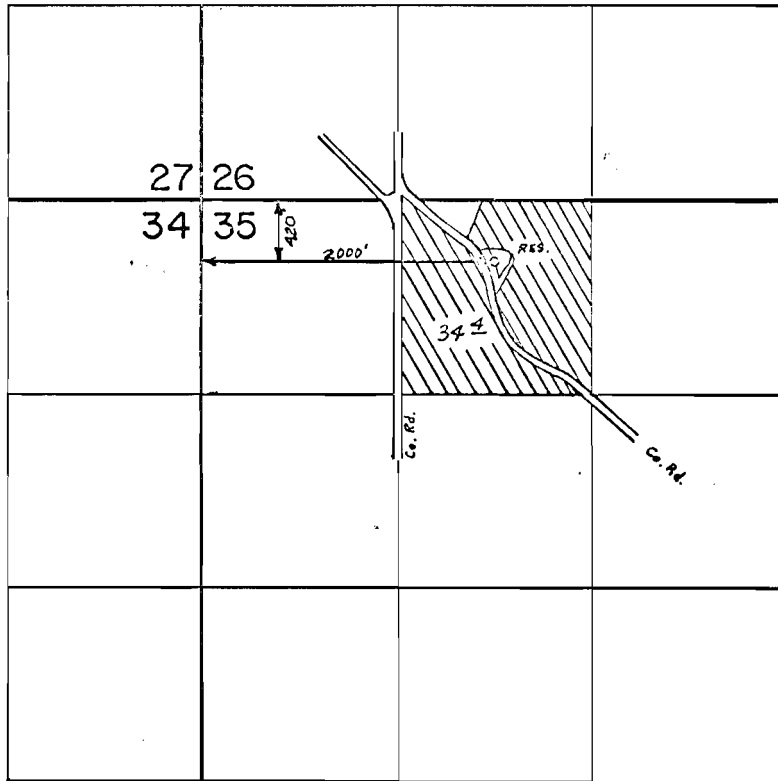

FINAL PROOF SURVEY UNDER

Application No. 42911 R-42910 Permit No. 32490 R-4991
IN NAME OF

ROBERT F. DESANTIS

Surveyed JUN 25 1973, by T.J. PAUL