T.6S. R.4W. W.M.

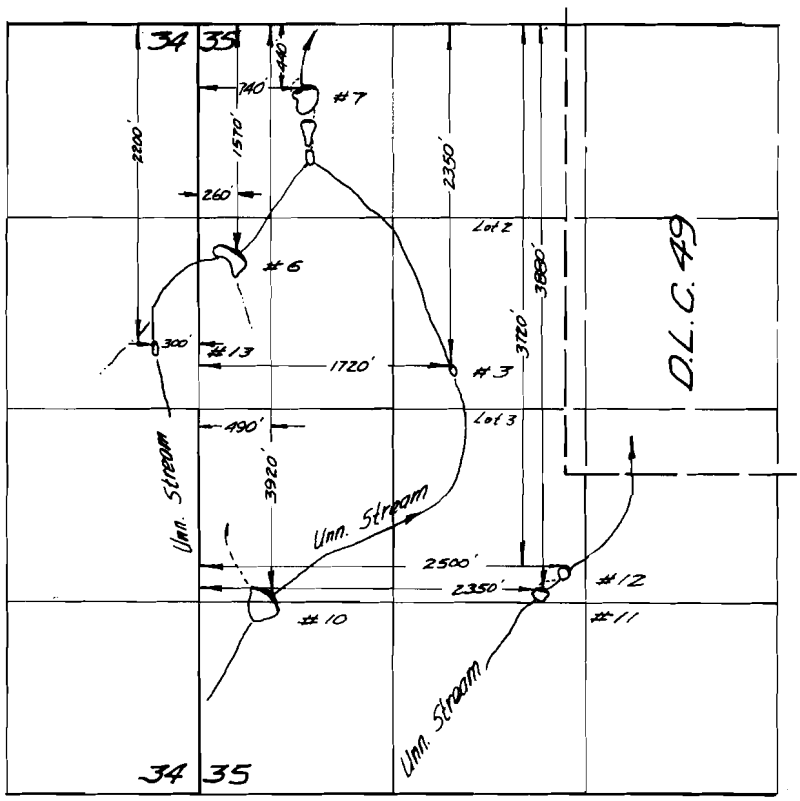

FINAL PROOF SURVEY
UNDER

Application No. R-43273 43274 Permit No. R-5390 34015

IN NAME OF

OREGON 4H FOUNDATION

Surveyed July 18 1974, March 7 1975 by L. H. Nunn