


T.6S. R.4W. W.M.

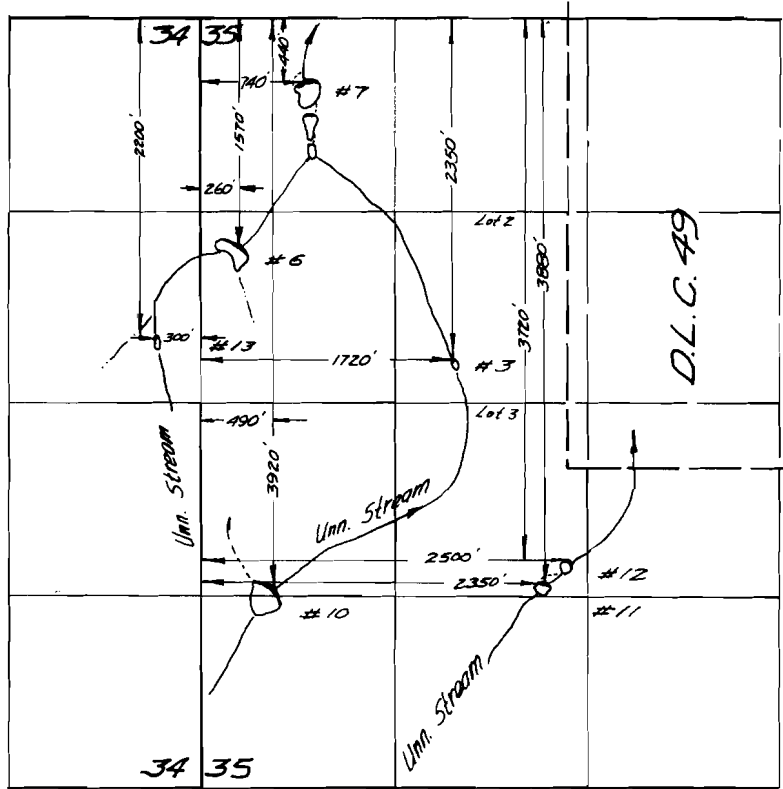

FINAL PROOF SURVEY
UNDER

R-43273 R-5390
Application No. 43274 Permit No. 34015
IN NAME OF

OREGON 4H FOUNDATION

Surveyed July 18, 1974 by L. H. Nunn
March 7, 1975