


T. 4 S. R. 10 W. W. M.

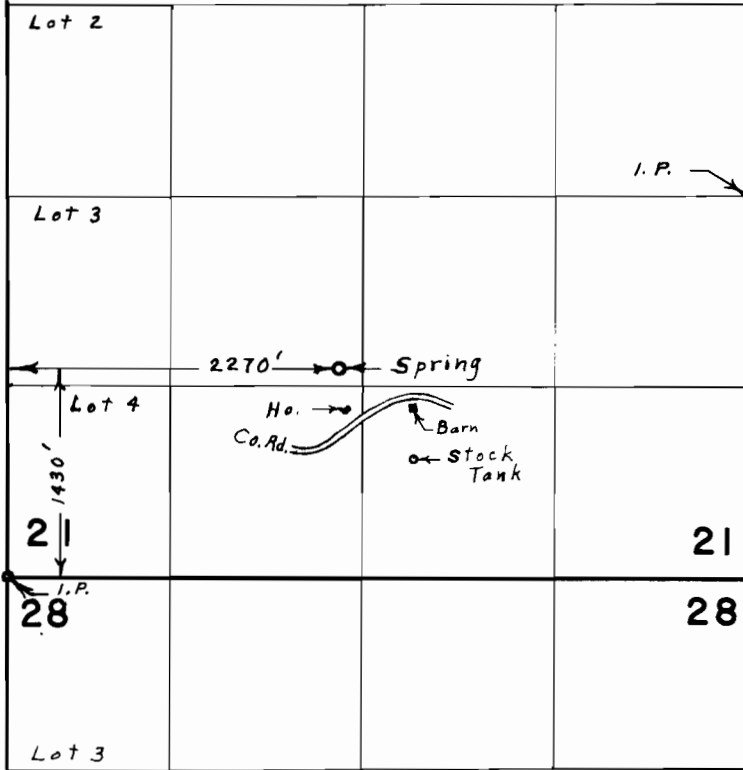

FINAL PROOF SURVEY UNDER

Application No. 45353 Permit No. 33864
IN NAME OF

EMERY A. & JENNIE L. BRANDT

June 26, 1974 L. M. Toll
Surveyed April 10, 1971, by L. E. Gould