


T.4 S. R.10 W. W.M.

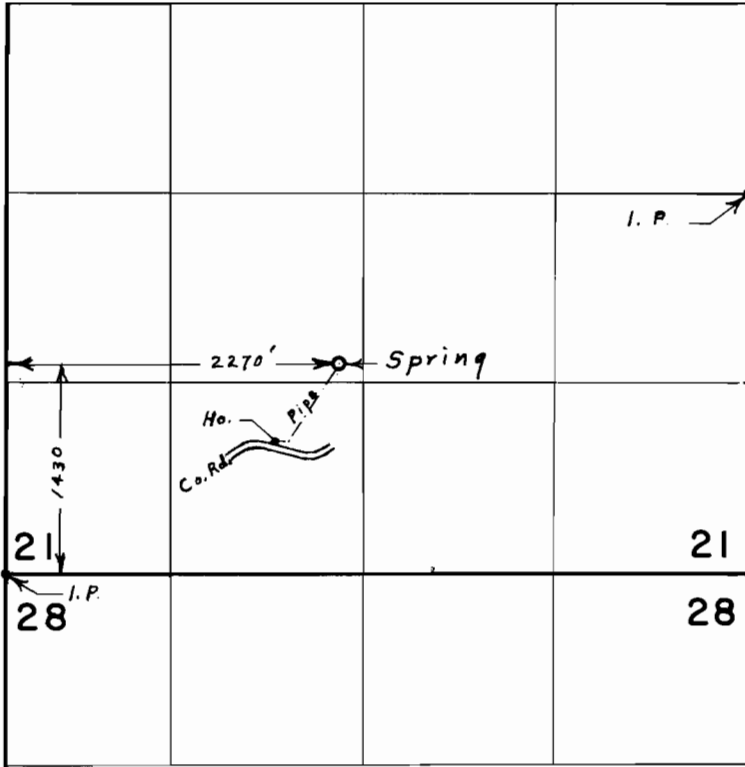

FINAL PROOF SURVEY
UNDER

Application No. 45371 Permit No. 33874
IN NAME OF

CECIL & HENRY KLINKER

June 26, 1974, by L. M. Toll
Surveyed Aug. 10, 1971, by L. E. Gould