


T.2N.,R.4W.,W.M.

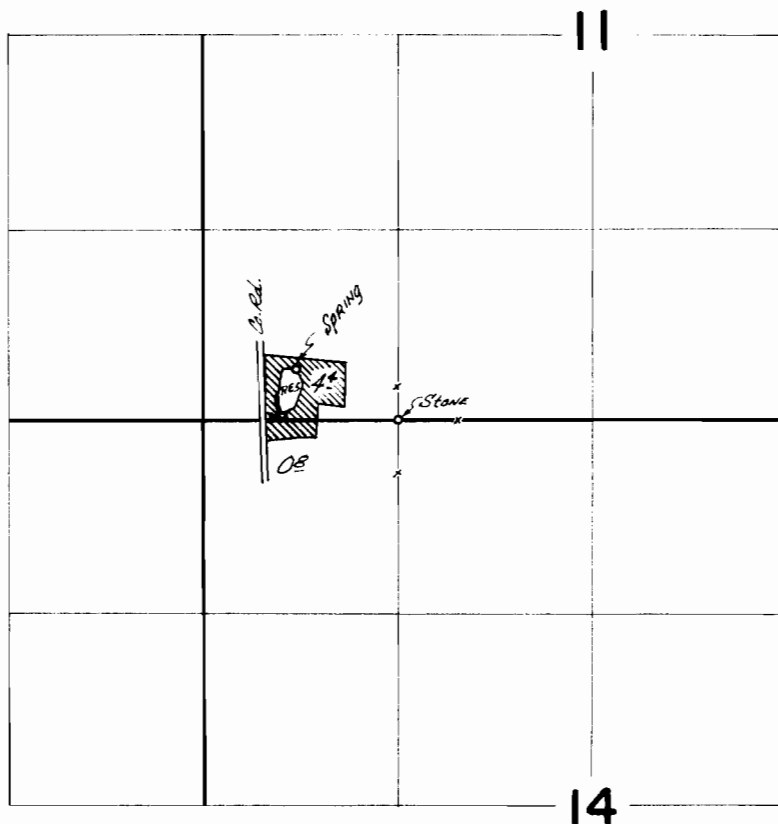

Div. Pts. - Spring - 350' N. & 700' W.; Res. - 50' N. & 760' W.; both from
SE cor. SW 1/4 SW 1/4 Sec. 11.

FINAL PROOF SURVEY
UNDER

R-47429 R-5682
Application No. 47195 Permit No. 35355
IN NAME OF

JAMES L. SEED

Surveyed JUNE 28 1973, by D. NORBY