


T.4S., R.4W., W.M.

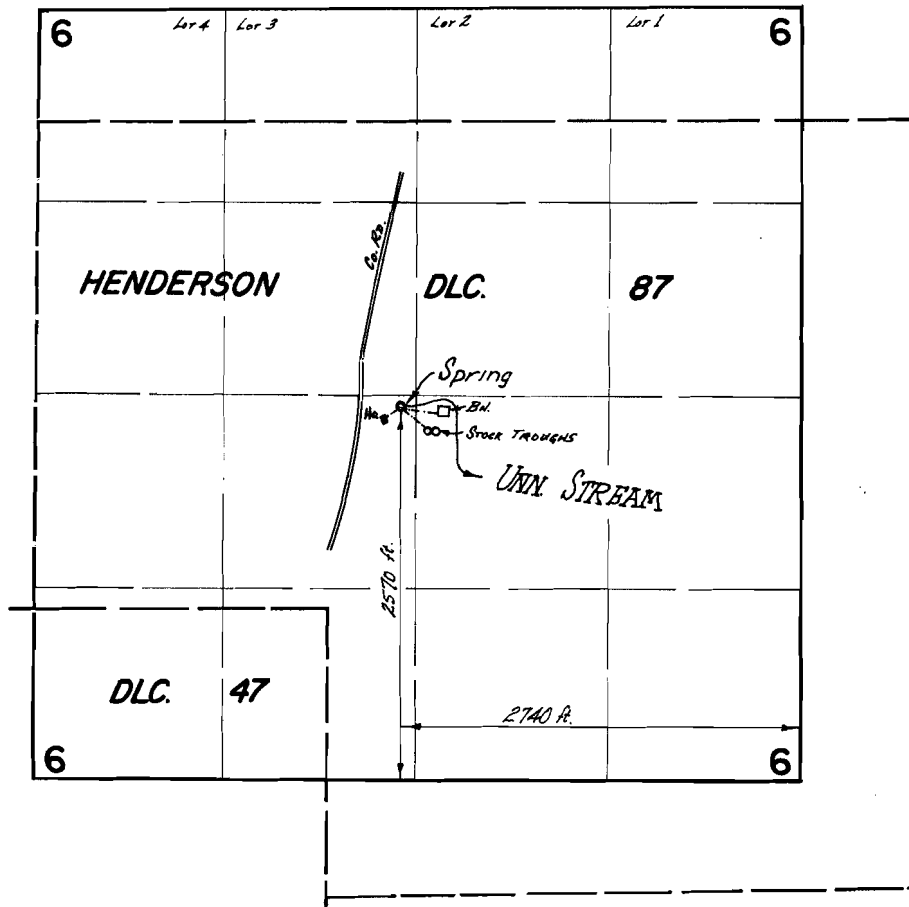

FINAL PROOF SURVEY
UNDER

Application No. 40354 Permit No. 29962
IN NAME OF

MRS. LILLIAN P. HENKLE

Surveyed April 27 1973, by L. E. GOULD