


T.3S.,R.3W.,W.M.

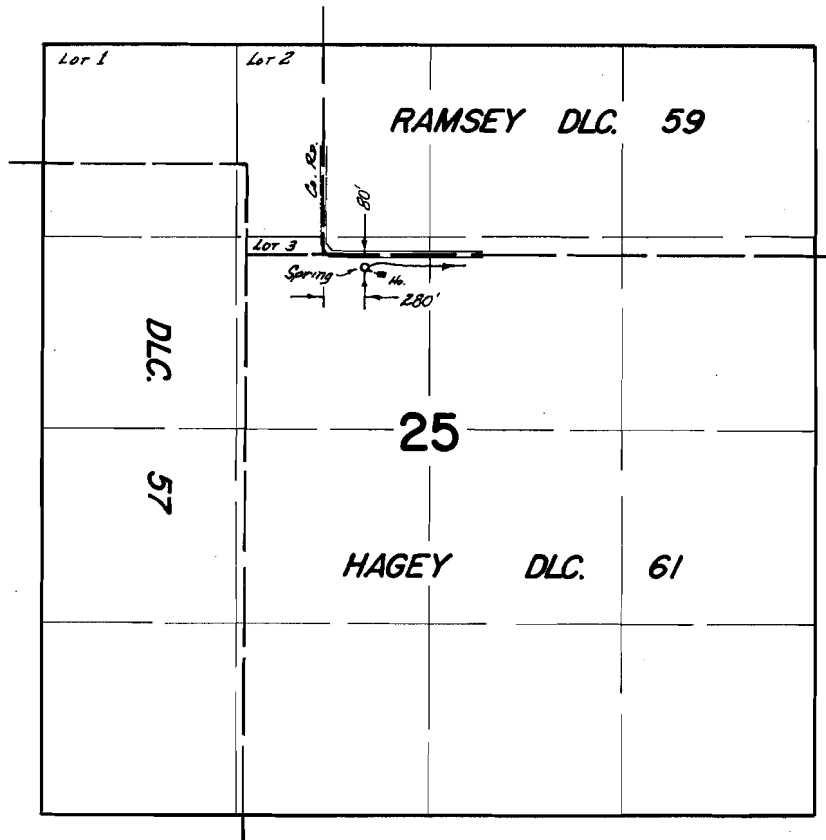

FINAL PROOF SURVEY
UNDER

Application No. 44145 Permit No. 32967
IN NAME OF

LYLE I. LEACH

Surveyed MARCH 29 1973, by L.E. GOULD