


T.3S.R.3W.W.M.

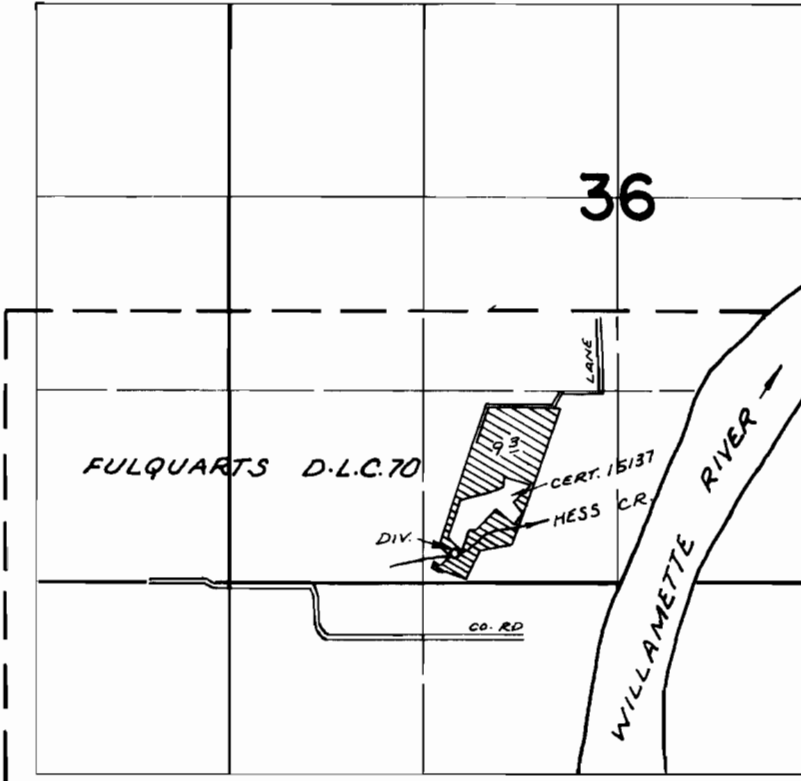

FINAL PROOF SURVEY
UNDER

Application No. 45251 Permit No. 33800
IN NAME OF

VITO VITTORIA

Surveyed MAR. 28, 1913, by L. E. GOULD