


T.5S. R.6W. W.M.

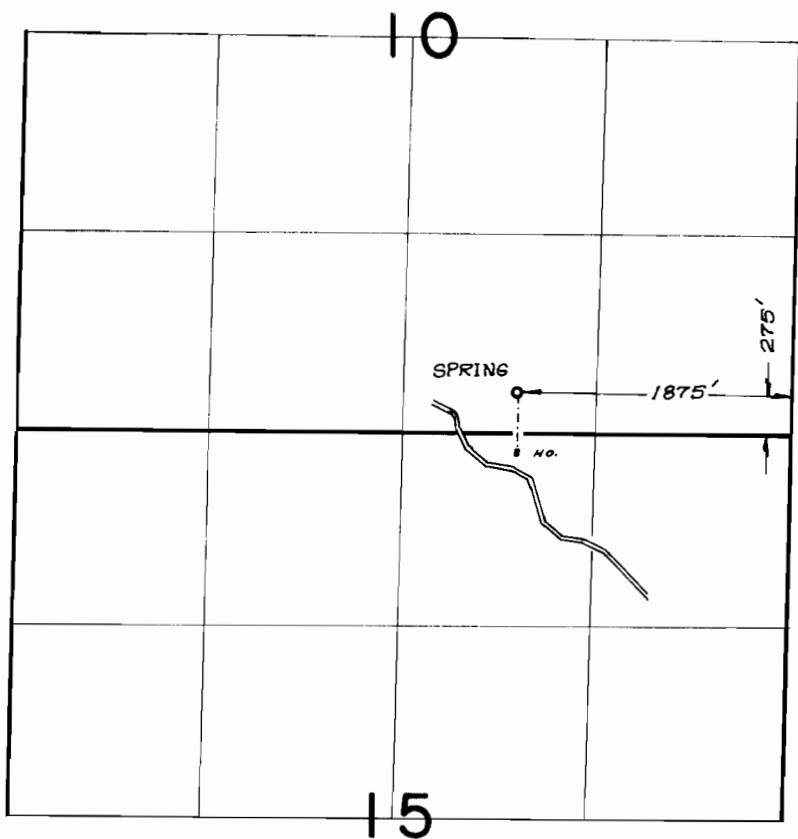

FINAL PROOF SURVEY
UNDER

Application No. 45451 Permit No. 33918
IN NAME OF

LINDSEY MFG. CO.

Surveyed MAY 31 1973, by R. MUCKEN