


T.3S. R.2W. W.M.

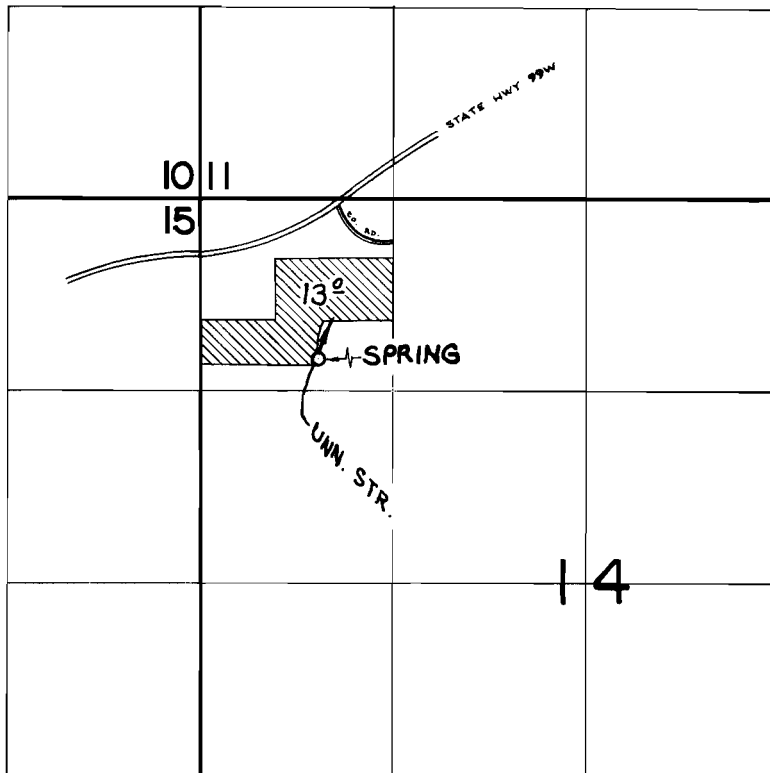

SPRING LOCATED: 1100' S. & 800' E. From NW cor. Section 14

**FINAL PROOF SURVEY**  
UNDER

Application No. 45978 Permit No. 34345  
IN NAME OF

HOWARD CAMPBELL &/OR WANDA KITTY ADAMS

Surveyed MARCH 28, 1973, by R.G. MUCKEN