


T.3&4S.,R.IW.,W.M.

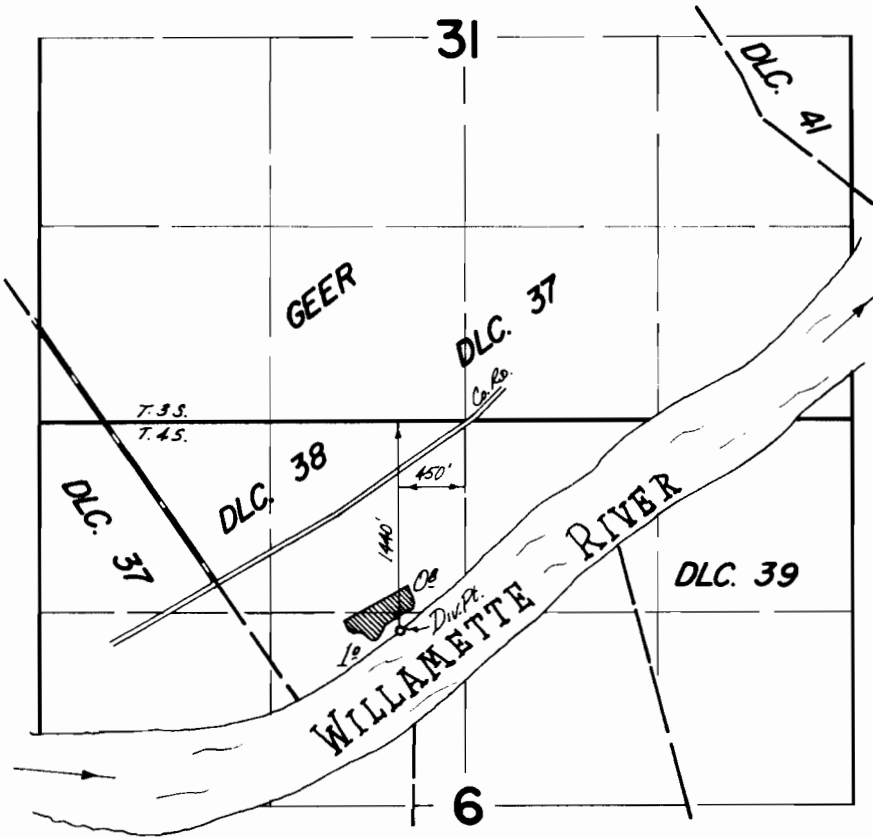

**FINAL PROOF SURVEY**  
UNDER

Application No. 46672 Permit No. 34982  
IN NAME OF

W. P. STALNAKER

Surveyed SEPT. 21 1973, by L. E. GOULD