


T. 4 S. R. 6 W. W.M.

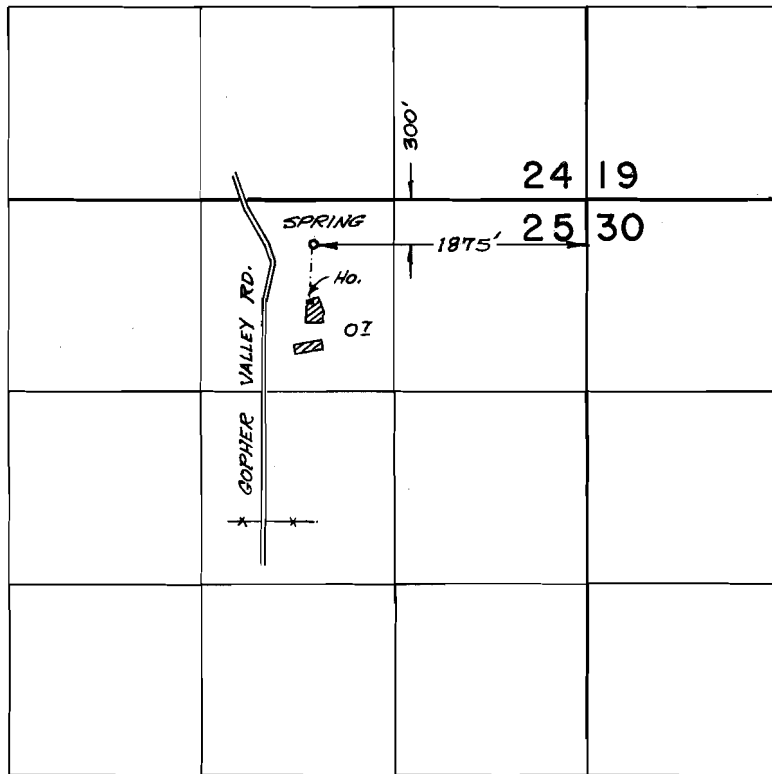

**FINAL PROOF SURVEY**  
UNDER

Application No. 48502 Permit No. 36394  
IN NAME OF

BILLY IVAN GOURLEY

Surveyed MAY 14 1973, by R. MUCKEN