


T.2S.,R.4&5W.,W.M.

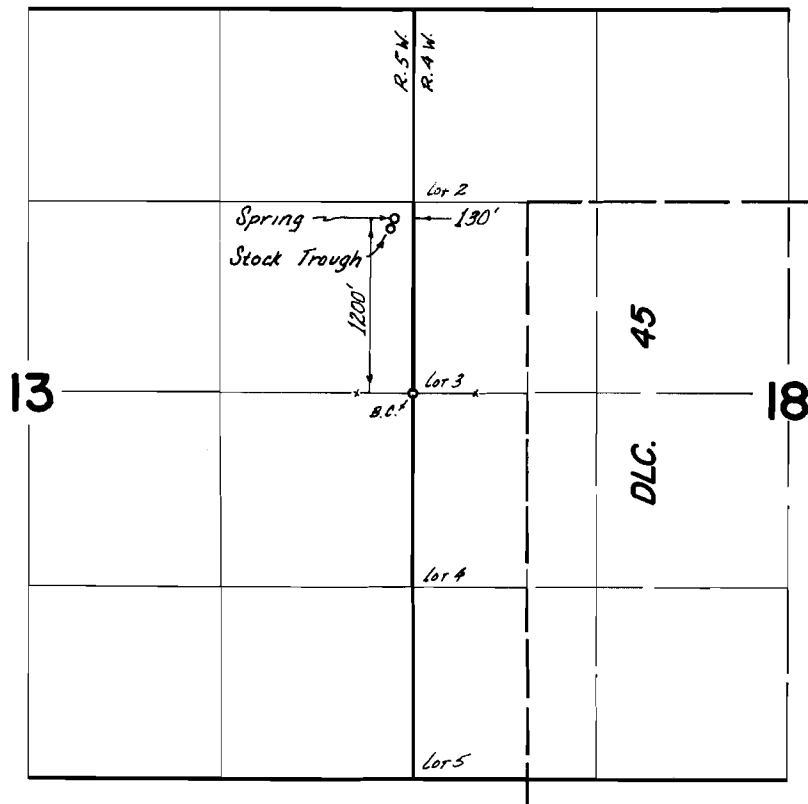

**FINAL PROOF SURVEY**  
UNDER

Application No. 48520 Permit No. 36404  
IN NAME OF

KENNETH R. EIESLAND

Surveyed April 26 1973, by L. E. GOWD