


T.3N.R.3W.W.M.

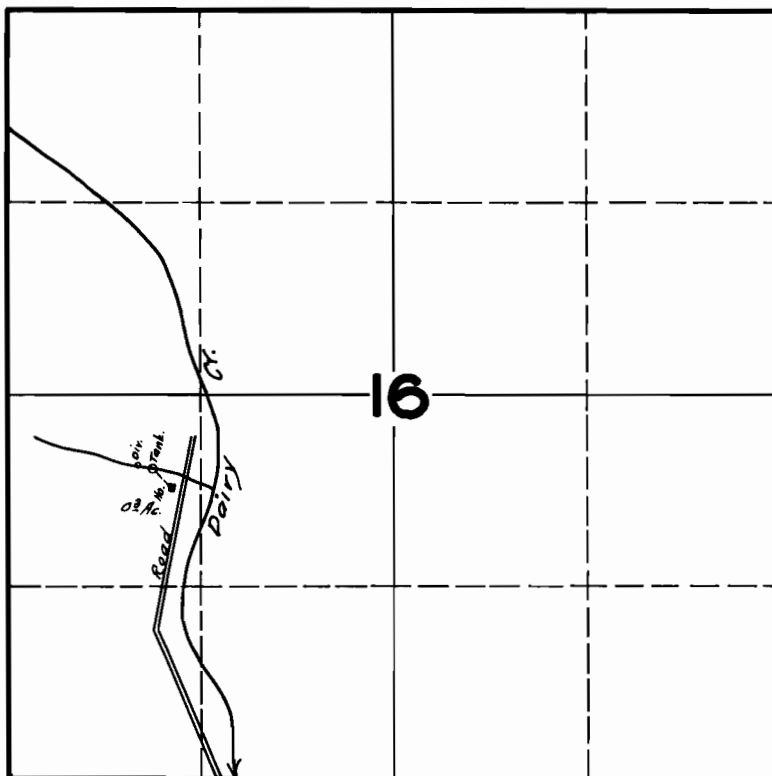

**FINAL PROOF SURVEY
UNDER**

Application No. 18980 Permit No. 14600

IN NAME OF

AUDREY HOFFMAN

Surveyed AUG. 30 1945, by J. B. Russell