


T.13&14S.R.5W.W.M.

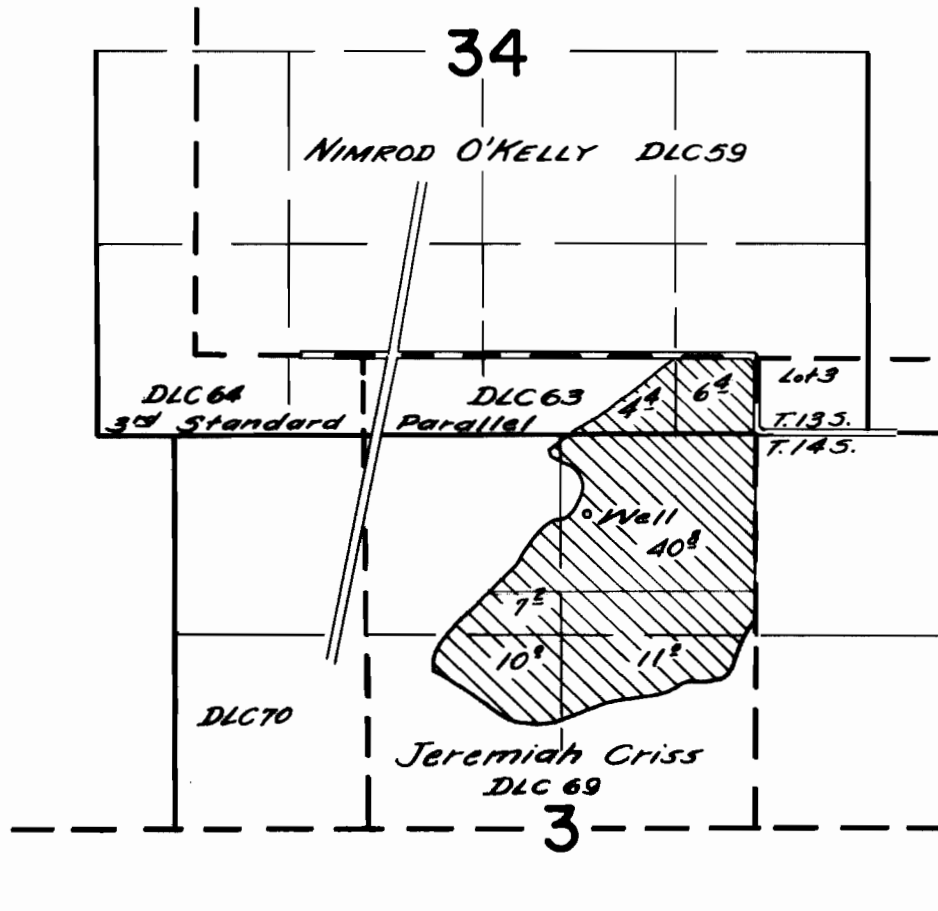

FINAL PROOF SURVEY
UNDER

Application No. G-496 Permit No. G-380
IN NAME OF

WILLIAM L. FRANKLIN

Surveyed June 2, 1961, by C. Banatta