


T. 2 S. R. 1 E. W. M.

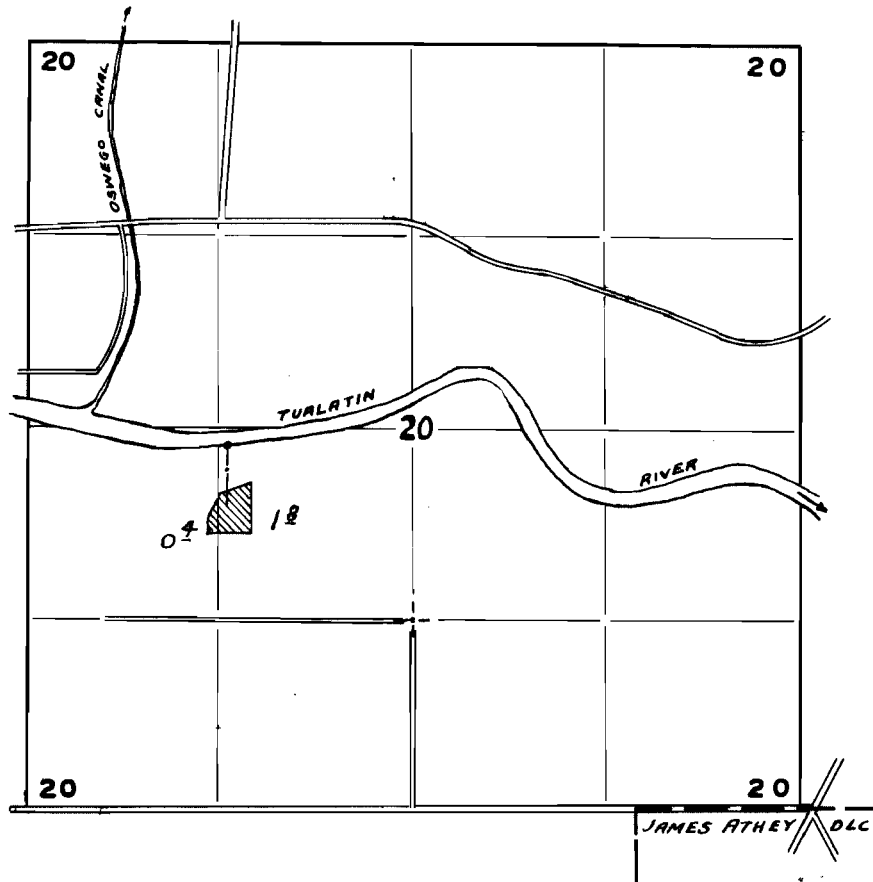

FINAL PROOF SURVEY

UNDER

Application No. 29375 Permit No. 23144

IN NAME OF

ROYAL BETTS

Surveyed 5-8 1956, by R. D. BEST