


T.4S.R.13E.W.M.

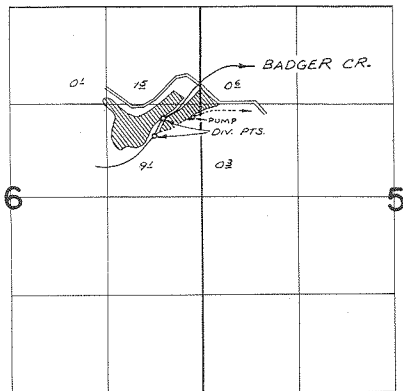

DIV. PTS. LOC: 3110'N. & 520'W; 3480'N. & 650'W, BOTH
FROM S.E. COR. SEC. 6

FINAL PROOF SURVEY UNDER

TRANSFER NO. C-199

Application No. Permit No.
IN NAME OF

EDWIN E. COBURN, ROBERT H. GUSTAFSEN, & HERB E. MCCREARY

Surveyed SEPT. 12, 1974, by D. NORBY