


T. 9 S. R. 1 E. W. M.

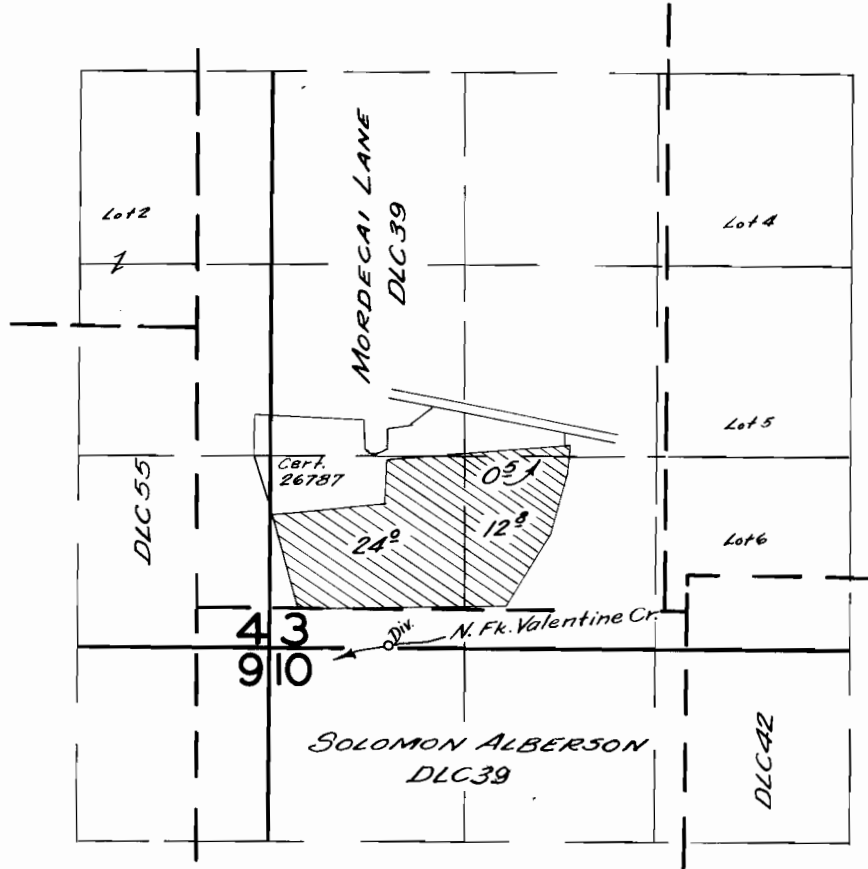

FINAL PROOF SURVEY UNDER

Application No. 31381 Permit No. 24742
IN NAME OF

ETZEL BROTHERS

Surveyed April 28 1961, by *COBART*