


# T.14 S., R.5 W., W.M.

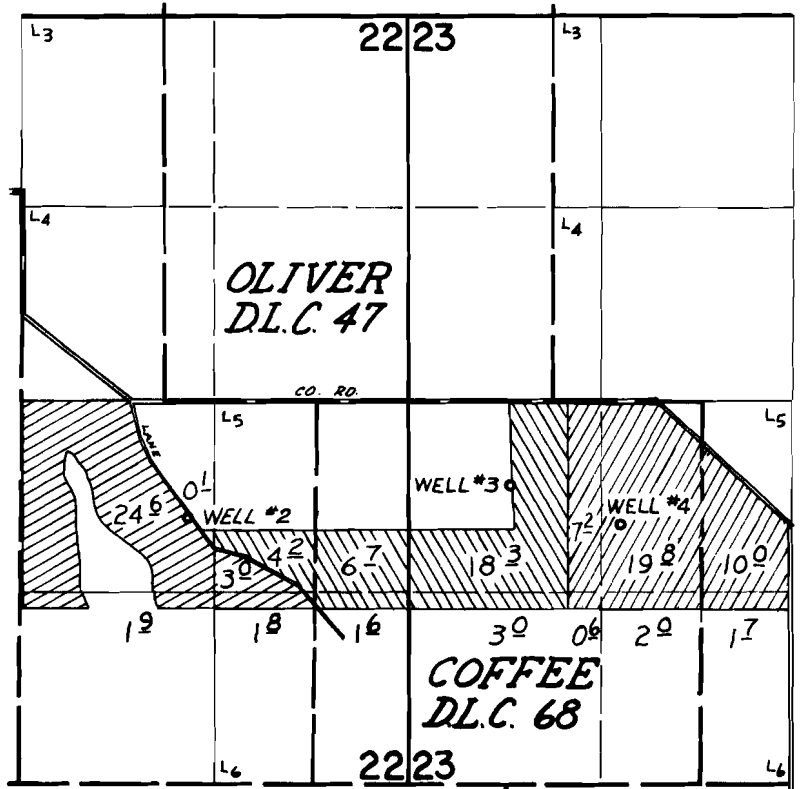

WELLS LOCATED: #2 - 800'S & 160'E; #3 - 570'S & 2370'E; #4 - 840'S & 3120'E, ALL FROM SW COR. OLIVER D.L.C. 47.

## FINAL PROOF SURVEY UNDER

Application No. G-5047 Permit No. G-4757  
IN NAME OF

CLARENCE AND MAXINE BECKER

Surveyed SEPT 18 1973, by D. NORBY

 WELL #2  
 WELL #3  
 WELL #4