


# T.25S.R.6W.W.M.

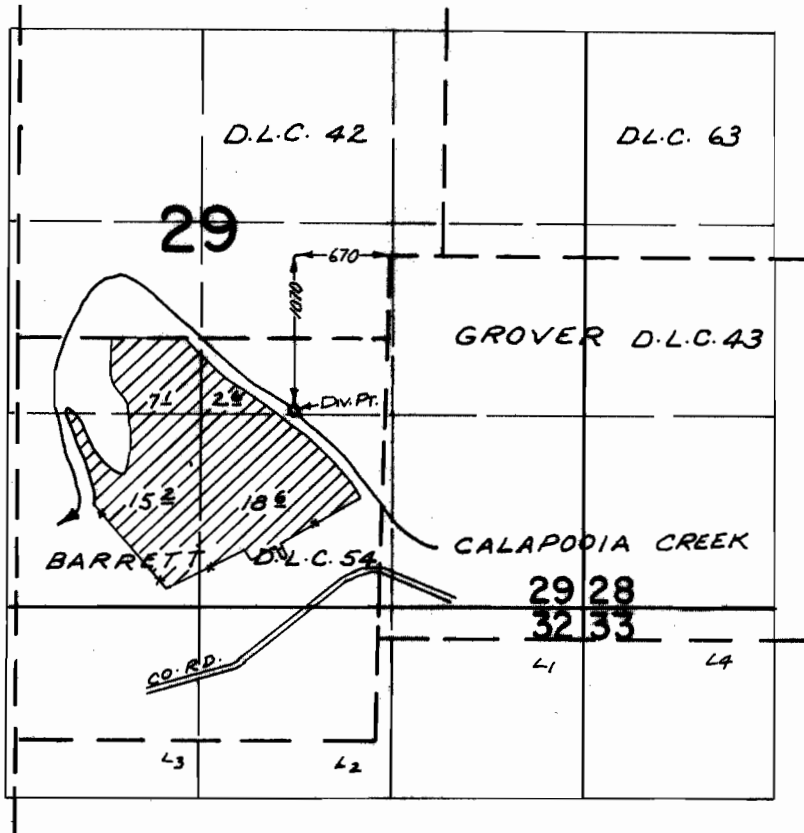

## FINAL PROOF SURVEY UNDER

Application No. 33749 Permit No. 32693  
IN NAME OF

HOMER & HAZEL WAYBRIGHT

Surveyed OCT. 14, 1974, by R. MUCKEN