


T.1N. R.19E. W.M.

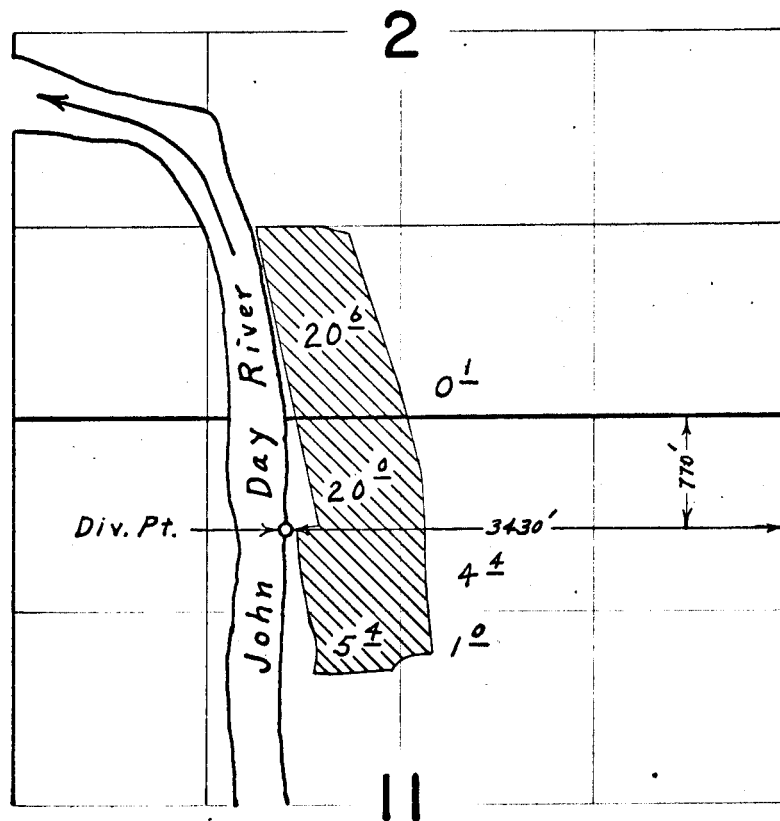

FINAL PROOF SURVEY
UNDER

Application No. 47815 Permit No. 35847
IN NAME OF

V. O. WEST

Surveyed April 9, 1974, by L. E. Gould