


# T.1S. R.21E. W.M.

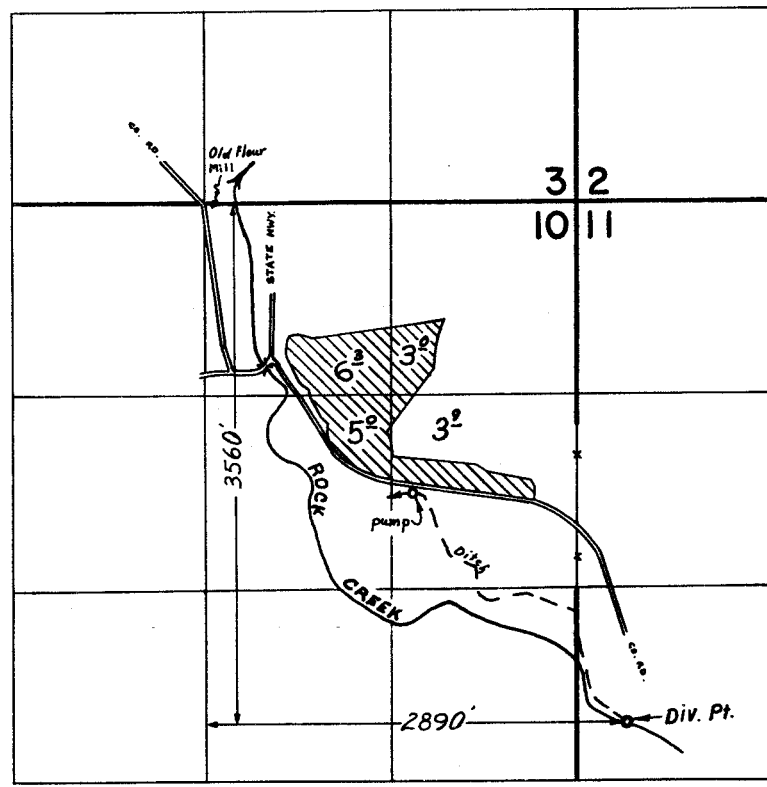

## FINAL PROOF SURVEY UNDER

Application No. 48313 Permit No. 36278  
IN NAME OF ~~48313~~

C-42183

ESTATE OF BENTLEY C. RIES

Surveyed APRIL 10, 1974, by L. E. GOULD